# Mann Hall Renovation

2501 Stinson Dr

Raleigh, NC 27607

## 17 JANUARY 2025 PW PROJECT #820937.001

## Perkins&Will

Charlotte, NC 28203 t 704.972.5600 f 704.972.5601 www.perkinswill.com

CONSULTANTS

Salas O'Brien

Lynch Mykins Structural Engineers

License (NC): F-1434

702 Oberlin Road, Raleigh, NC 27605

Holder Construction Group 6210 Ardrey Kell Road Suite 400, Charlotte, NC 28277

5700 Six Forks Road, Suite 203, Raleigh, NC 27609

**Ecoimpact Consulting** 8022 Providence Road Suite 500, Charlotte, NC 28277

Mann Hall Renovation

STATE ID #22-24500-02B NCSU PROJECT # 202220021

Facilities Division Design & Construction Administrative Services Building III


2601 Wolf Village Way, Suite 331 Raleigh, NC 27695


# CONSTRUCTION DOCUMENTS VOLUME 1


| Perkins&Will | Perkins&Will |
|--------------|--------------|
|              |              |

| OWNER   | ARCHITECT | INTERIOR DESIGN  | STRUCTURAL   | MEP | CIVIL  | CONTRACTOR | AUDIO/VISUAL  | LIGHTING  | SUSTAINABILITY   | STATE CONSTRUCTION OFFICE  |
|---|-----------|--|--|-----|--|------------|---|---|--|--|
| North Carolina State University Facilities Division Design & Construction Administrative Services Building III 2601 Wolf Village Way, Suite 331, Raleigh, NC 27695 (919) 515-2011 (TEL) | 27701     | Perkins&Will<br>411 W. Chapel Hill Street Suite 200, Durham, NC<br>27701<br>(919) 433-5300 (TEL) | Lynch Mykins Structural Engineers<br>301 N. West Street Suite 105, Raleigh, NC 27603<br>(919) 782-1833 (TEL) |     | NV5 Engineers and Consultants<br>3300 Regency Parkway Suite 100, Cary, NC<br>27518<br>(919) 836-4800 (TEL) | · ·        | NV5 Engineers and Consultants<br>4905 Professional Court, Raleigh, NC 27609<br>(919) 876-9799 (TEL) | Available Light<br>5700 Six Forks Road, Suite 203, Raleigh, NC<br>27609<br>(212) 977-2611 (TEL) | Ecoimpact Consulting<br>8022 Providence Road Suite 500, Charlotte, NC<br>28277<br>(212) 977-2611 (TEL) | 301 N Wilmington St # 450, Raleigh, NC 27601<br>(919) 807-4100 (TEL) |

|                        | SHE   | ET INDEX                 |                               |  |
|------------------------|---|--------------------------|-------------------------------|--|
| SHEET<br>NUMBER        | SHEET NAME  | ISSUE FOR BID -<br>DEMO  | ISSUE FOR BID -<br>DEMO REV 1 | ISSUE FOR PROCURE!                     |
| 01-GENERAL             |   |                          |                               |  |
| G00-00                 | COVER SHEET AND INDEX OF DRAWINGS   | 04/17/2024               | 10/28/2024                    | 01/17/202                              |
| G01-01                 | CODE COMPLIANCE DATA - DEMOLITION   | 04/17/2024               | 10/28/2024                    | <b>§</b> 01/17/202                     |
| G01-02                 | SITE LOGISTICS PLAN   |                          | 10/28/2024                    | Lum                                    |
| 04-ARCHITEC            | ΤΙΙΡΑΙ  |                          |                               |  |
| A00-01A                | REFERENCE SHEET   | 04/17/2024               | 10/28/2024                    | ~~~~~                                  |
| A00-10                 | EXTERIOR ASSEMBLIES   |                          |                               | 01/17/202                              |
| A04-01                 | DEMOLITION PLAN - FLOOR 01  | 04/17/2024               | 10/28/2024                    | 01/17/202                              |
| A04-02                 | DEMOLITION PLAN - FLOOR 02  | 04/17/2024               | 10/28/2024                    | 01/17/202                              |
| A04-03                 | DEMOLITION PLAN - FLOOR 03  | 04/17/2024               | 10/28/2024                    | <b>§</b> 01/17/202                     |
| A04-04                 | DEMOLITION PLAN - FLOOR 04  | 04/17/2024               | 10/28/2024                    | 01/17/202                              |
| A04-05                 | DEMOLITION PLAN - ROOF  | 04/17/2024               | 10/28/2024                    | 01/17/202                              |
| A04-11                 | DEMOLITION REFLECTED CEILING PLAN - FLOOR 01                                | 04/17/2024               | 10/28/2024                    | ميمت                                   |
| A04-12                 | DEMOLITION REFLECTED CEILING PLAN - FLOOR 02                                | 04/17/2024               | 10/28/2024                    |  |
| A04-13                 | DEMOLITION REFLECTED CEILING PLAN - FLOOR 03                                | 04/17/2024               | 10/28/2024                    |  |
| A04-14<br>A05-10       | DEMOLITION REFLECTED CEILING PLAN - FLOOR 04 DEMOLITION EXTERIOR ELEVATIONS | 04/17/2024               | 10/28/2024                    | 01/17/202                              |
| A05-10<br>A05-11       | DEMOLITION EXTERIOR ELEVATIONS  DEMOLITION EXTERIOR ELEVATIONS              |                          | <br>                          | 01/17/202                              |
| A05-11<br>A05-12       | DEMOLITION EXTERIOR ELEVATIONS  DEMOLITION EXTERIOR ELEVATIONS              |                          | <del></del>                   | 01/17/202                              |
| A11-06                 | FLOOR PLAN - ROOF   |                          | <br>                          | 01/17/202                              |
| A31-00                 | WALL SECTIONS   | <u></u>                  |                               | 01/17/202                              |
| A32-01                 | EXTERIOR ENVELOPE DETAILS   |                          | <u></u>                       | 01/17/202                              |
| A32-02                 | EXTERIOR ENVELOPE DETAILS   |                          |                               | 01/17/202                              |
| A32-03                 | EXTERIOR ENVELOPE DETAILS   |                          |                               | 01/17/202                              |
| A32-04                 | EXTERIOR ENVELOPE DETAILS   |                          |                               | 01/17/202                              |
| A32-05                 | EXTERIOR ENVELOPE DETAILS   |                          | <b></b>                       | 01/17/202                              |
| A32-10                 | EXTERIOR EXPANSION CONTROL  |                          |                               | 01/17/202                              |
| A42-01                 | ELEVATOR PLANS AND SECTIONS   |                          |                               | 01/17/202                              |
| A42-50                 | EDGE OF SLAB AND SHAFT DETAILS  |                          |                               | 01/17/202                              |
|                        |   |                          |                               | hum                                    |
| 05-STRUCTUR            |   |                          |                               | ~~~~~~~~~~~~~~~~~~~~~~~~~~~~~~~~~~~~~~ |
| S00-01                 | GENERAL NOTES   |                          |                               | 01/17/202                              |
| S00-02                 | GENERAL NOTES   |                          | <b></b>                       | 01/17/202                              |
| S11-01                 | FOUNDATION AND SLAB-ON-GRADE DEMOLITION PLAN - FLOOR 00                     |                          | <del></del>                   | 01/17/202                              |
| S11-02                 | FOUNDATION AND SLAB-ON-GRADE PLAN - FLOOR 00                                |                          |                               | 01/17/202                              |
| S11-03                 | FRAMING PLAN - FLOOR 01   |                          |                               | 01/17/202                              |
| S11-04                 | SLAB PLAN - FLOOR 01  |                          |                               | 01/17/202                              |
| S12-01                 | FRAMING/SLAB PLAN - FLOOR 02  |                          |                               | 01/17/202                              |
| S13-01                 | FRAMING/SLAB PLAN - FLOOR 03  |                          |                               | 01/17/202                              |
| S14-01                 | FRAMING/SLAB PLAN - FLOOR 04  |                          |                               | 01/17/202                              |
| S15-01                 | FRAMING/SLAB PLAN - ROOF  |                          |                               | 01/17/202                              |
| S16-01                 | FRAMING/SLAB PLAN - PENTHOUSE   |                          |                               | 01/17/202                              |
| S16-02                 | DECK PLAN - PENTHOUSE   |                          |                               | 01/17/202                              |
| S30-01<br>S30-02       | SECTIONS<br>SECTIONS  |                          | <del></del>                   | 01/17/202                              |
| S30-02<br>S30-03       | SECTIONS  |                          | <br>                          | 01/17/202                              |
| S30-03                 | SECTIONS  |                          |                               | 01/17/202                              |
| S40-01                 | ENLARGED FOUNDATION AND SLAB-ON-GRADE PLAN                                  |                          |                               | 01/17/202                              |
| ••                     | - FLOOR 00  |                          |                               | \ \ \ \ \ \ \ \ \ \ \ \ \ \ \ \ \ \ \  |
| S40-02                 | ENLARGED FRAMING PLAN - FLOOR 01  |                          |                               | 01/17/202                              |
| S40-03                 | ENLARGED SLAB PLAN - FLOOR 01   |                          |                               | 01/17/202                              |
| S40-04                 | EXIT ACCESS STAIR PLANS AND SECTIONS  |                          |                               | 01/17/202                              |
| S50-01                 | TYPICAL DETAILS   |                          |                               | 01/17/202                              |
| S50-02                 | TYPICAL DETAILS   |                          |                               | 01/17/202                              |
| S50-03                 | TYPICAL DETAILS   |                          |                               | 01/17/202                              |
| S50-04                 | TYPICAL DETAILS   |                          |                               | 01/17/202                              |
| S50-05                 | TYPICAL DETAILS   |                          |                               | 01/17/202                              |
| 07 - PLUMBING          |   |                          |                               |  |
| P04-00                 | STANDARDS, SYMBOLS & ABBREVIATIONS - DEMO                                   | 04/17/2024               | 10/28/2024                    | -                                      |
| P04-01                 | DEMOLITION PLAN - FLOOR 01  | 04/17/2024               | 10/28/2024                    |  |
| P04-02                 | DEMOLITION PLAN - FLOOR 02  | 04/17/2024               | 10/28/2024                    |  |
| P04-03                 | DEMOLITION PLAN - FLOOR 03  | 04/17/2024               | 10/28/2024                    | -                                      |
| P04-04<br>P04-05       | DEMOLITION PLAN - FLOOR 04 DEMOLITION PLAN - ROOF                           | 04/17/2024<br>04/17/2024 | 10/28/2024<br>10/28/2024      |  |
|                        |   |                          | <del></del>                   | 1                                      |
| 08 - MECHANI<br>H04-00 | CAL<br>STANDARDS, SYMBOLS & ABBREVIATIONS - DEMO                            | 04/17/2024               | 10/28/2024                    |  |
| H04-00<br>H04-01       | DEMOLITION PLAN - FLOOR 01  | 04/17/2024               | 10/28/2024                    |  |
| H04-01                 | DEMOLITION PLAN - FLOOR 01 DEMOLITION PLAN - FLOOR 02                       | 04/17/2024               | 10/28/2024                    | -                                      |
| H04-02                 | DEMOLITION PLAN - FLOOR 02  | 04/17/2024               | 10/28/2024                    | -                                      |
| H04-04                 | DEMOLITION PLAN - FLOOR 03  DEMOLITION PLAN - FLOOR 04                      | 04/17/2024               | 10/28/2024                    | -                                      |
| H04-05                 | DEMOLITION PLAN - ROOF  | 04/17/2024               | 10/28/2024                    |  |
| 09 - ELECTRIC          | AL  |                          |                               |  |
| E04-00                 | STANDARDS, SYMBOLS & ABBREVIATIONS - DEMO                                   | 04/17/2024               | 10/28/2024                    |  |
| E04-01E                | DEMOLITION PLAN - FLOOR 01 - POWER  | 04/17/2024               | 10/28/2024                    |  |
| E04-01L                | DEMOLITION PLAN - FLOOR 01 - LIGHTING                                       | 04/17/2024               | 10/28/2024                    |  |
| E04-02                 | DEMOLITION PLAN - FLOOR 02  | 04/17/2024               | 10/28/2024                    |  |
| E04-03                 | DEMOLITION PLAN - FLOOR 03  | 04/17/2024               | 10/28/2024                    | -                                      |
| E04-04                 | DEMOLITION PLAN - FLOOR 04  | 04/17/2024               | 10/28/2024                    |  |
| E04-05                 | DEMOLITION PLAN - ROOF  | 04/17/2024               | 10/28/2024                    |  |

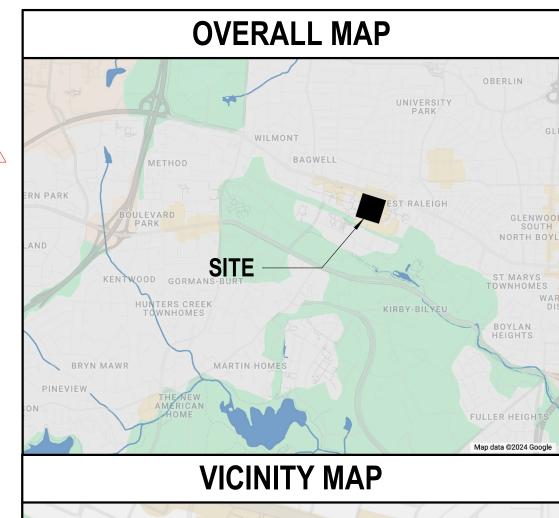

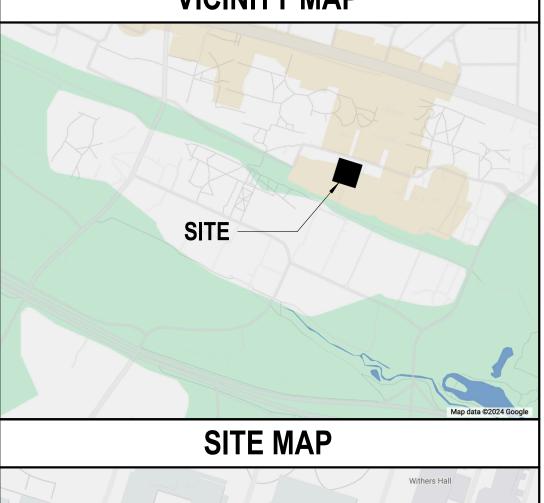

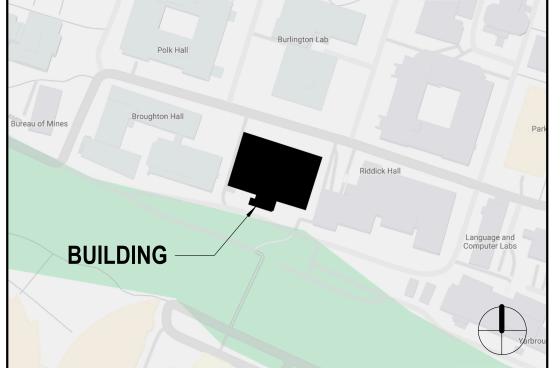

| TRUE | ISSUE CHA |
|------|-----------|
|      | ISSUE CHA |

|       |                              | TITLE        |  |  |
|-------|------------------------------|--------------|--|--|
| Appro | ved                          | Approve      |  |  |
| Check | ed                           | Checker      |  |  |
| Drawr | 1                            | Author       |  |  |
| Job N | <b>Job Number</b> 820937.001 |              |  |  |
| MARK  | ISSUE                        | DATE         |  |  |
| 1     | ISSUE FOR BID - DEMO         | 4/17/2024    |  |  |
| 2     | ISSUE FOR BID - DEMO REV     | 1 10/28/2024 |  |  |
| 3     | ISSUE FOR BID - PROC         | 01/17/2025   |  |  |

**COVER SHEET AND INDEX OF DRAWINGS** 

SHEET NUMBER

Copyright © 2024 Perkins+Will

G00-00

#### ("Other" should include firms and individuals such as truss, precast, pre-engineered, interior designers, etc.)

#### **BUILDING CODE**

**2018 NC BUILDING CODE:** □ New Building □ Addition □ Renovation □ First Time Interior Completion ☐ Shell/Core - Contact the local inspection jurisdiction for possible additional procedures & requirements

☐ Phased Construction - Shell/Core - Contact the local inspection jurisdiction for possible additional procedures & requirements 2018 NC EXISTING BUILDING CODE: □ N/A □ Prescriptive □ Repair □ Chapter 14 □ Alteration Level I □ Alteration Level II ■ Alteration Level III

☐ Historic Property ☐ Change of Use

CONSTRUCTED: (date) 1964 CURRENT OCCUPANCY(S): (Ch. 3) RENOVATED: (date) PROPOSED OCCUPANCY(S): (Ch. 3)

OCCUPANCY CATEGORY (Table 1604.5): Current: 

N/A Proposed: □ N/A □ I ■ II □ IV

□ I-A

#### BASIC BUILDING DATA ☐ III-A ☐ II-A $\square$ IV

□ N/A □ NFPA 13 □ NFPA 13R □ NFPA 13D

|         |                  | <b>Gross Building Area Table</b> |             |           |  |
|---------|------------------|----------------------------------|-------------|-----------|--|
| FLOOR   | EXISTING (SQ FT) | RENOVATED (SQ FT)                | NEW (SQ FT) | SUB-TOTAL |  |
| FLOOR 4 | 18,646           | 18,646                           |             | 18,646    |  |
| FLOOR 3 | 18,646           | 18,646                           |             | 18,646    |  |
| FLOOR 2 | 16,941           | 16,941                           |             | 16,941    |  |
| FLOOR 1 | 23,291           | 23,291                           |             | 23,291    |  |
| TOTAL   | 77,524           | 77,524                           |             | 77,524    |  |

| ALLOWABLE AREA       |                |                  |               |              |           |     |  |
|----------------------|----------------|------------------|---------------|--------------|-----------|-----|--|
| Primary Occupancies: |                |                  |               |              |           |     |  |
| Assembly             | ☐ A-1          | □ A-2            | □ A-3         | □ A-4        | □ A-5     |     |  |
| Business             |                |                  |               |              |           |     |  |
| Educational          |                |                  |               |              |           |     |  |
| Factory              | ☐ F-1 Moderate | ☐ F-2 Low        |               |              |           |     |  |
| Hazardous            | ☐ H-1 Detonate | ☐ H-2 Deflagrate | ☐ H-3 Combust | ☐ H-4 Health | ☐ H-5 HPM |     |  |
| Institutional        | □ I-1          | □ I-2            | □ I-3         | □ I-4        |           |     |  |
|                      | I-3 Condition  | □ 1              | □ 2           | □ 3          | □ 4       | □ 5 |  |
| Mercantile           |                |                  |               |              |           |     |  |
| Residential          | □ R-1          | □ R-2            | □ R-3         | □ R-4        |           |     |  |
| Storage              | ☐ S-1 Moderate | ☐ S-2 Low        | ☐ High-piled  |              |           |     |  |

Accessory Occupancy Classification(s) \_\_\_\_N/A - DEMOLITION / EARLY PROCUREMENT ONLY

 □ 402
 □ 403
 □ 404
 □ 405
 □ 406
 □ 407
 □ 408
 □ 409
 □ 410
 □ 411
 □ 412

 (Ch 4 - List Code Sections) ☐ 413 ☐ 414 ☐ 415 ☐ 416 ☐ 417 ☐ 418 ☐ 419 ☐ 420 ☐ 421 ☐ 422 ☐ 423  $\square$  424  $\square$  425  $\square$  426  $\square$  427

Special Provisions (Ch 5 - List Code Sections):

Storage (Parking Garage) 

Open

Utility and Miscellaneous

■ No ☐ Yes Separation: \_\_\_\_\_ Hr. Exception:\_

☐ Yes ☐ No ☐ Non-Separated Use (508.3) ☐ Separated Use (508.4) See below for area calculations for each story, the area of the occupancy shall be such that the sum of the ratios of the actual floor area of each use divided by the allowable floor area for each use shall not exceed 1.

> Actual Area of Occupancy A Actual Area of Occupancy B Allowable Area of Occupancy A Allowable Area of Occupancy B

| STORY<br>NO. | DESCRIPTION<br>AND USE | (A)<br>BLDG. AREA PER<br>STORY (ACTUAL) | (B)<br>TABLE 506.2 <sup>4</sup><br>AREA | (C)<br>AREA FOR FRONTAGE<br>INCREASE <sup>1,5</sup> | (D)<br>ALLOWABLE AREA PER<br>STORY OR UNLIMITED <sup>2,3</sup> |
|--------------|------------------------|---|---|---|--|
| 4            | BUSINESS / UNOCCUPIED  | 18,646 SF                               | 23,000 SF                               | 14,375 SF   | 37,375 SF  |
| 3            | BUSINESS / UNOCCUPIED  | 18,646 SF                               | 23,000 SF                               | 14,375 SF   | 37,375 SF  |
| 2            | BUSINESS / UNOCCUPIED  | 16,941 SF                               | 23,000 SF                               | 14,375 SF   | 37,375 SF  |
| 1            | BUSINESS / UNOCCUPIED  | 23,291 SF                               | 23,000 SF                               | 14,375 SF   | 37,375 SF  |

- 1 Frontage area increases from Section 506.2 are computed thus:
- a. Perimeter which fronts a public way or open space having 20 feet minimum width =  $\frac{610}{}$  (F) b. Total Building Perimeter = 610 (P)
- c. Ratio (F/P) = \_\_\_\_\_(F/P) d. W = Minimum width of public way =  $\frac{25}{}$  (W)
- e. Percentage of frontage increase  $I_f = [F/P 0.25] \times W/30 = \frac{62.5}{}$  (%)
- 2 Unlimited area applicable under conditions of Section 507. 3 Maximum Building Area = total number of stories in the building x D (maximum 3 stories) (506.2).
- <sup>4</sup> The maximum area of open parking garages must comply with Table 406.5.4. The maximum area of air traffic control towers must comply with Table 412.3.1. <sup>5</sup> Frontage increase is based on the unsprinklered area value in Table 506.2

|  | ALLOWABLE | SHOWN ON PLANS                 | CODE REFERENCE |
|--|-----------|--------------------------------|----------------|
| Building Height in Feet (Table 504.3)    | 55 FT     | EXISTING TO REMAIN - 55 FT     |                |
| Building Height in Stories (Table 504.4) | 3 STORIES | EXISTING TO REMAIN - 3 STORIES |                |

**ALLOWABLE HEIGHT** 

| Provide code reference if the "Shown or | n Plans" quantity is not based on Table 504.3 | 3 or 504.4. |
|---|---|-------------|


### FIRE PROTECTION REQUIREMENTS

| BUILDING ELEMENT   | FIRE                             |       | RATING                         | DETAIL#       | DESIGN#               | SHEET # FOR          | SHEET #                |
|--|----------------------------------|-------|--------------------------------|---------------|-----------------------|----------------------|------------------------|
| DOLLDING ELLINEITI                                       | SEPARATION<br>DISTANCE<br>(FEET) | REQ'D | PROVIDED<br>(W/*<br>REDUCTION) | AND<br>SHEET# | FOR RATED<br>ASSEMBLY | RATED<br>PENETRATION | FOR<br>RATED<br>JOINTS |
| Structural Frame, including columns, girders, trusses    |                                  |       |                                |               |                       |                      |                        |
| Bearing Walls  |                                  |       |                                |               |                       |                      |                        |
| Exterior   | -                                | 0     | EXISTING TO REMAIN             |               |                       |                      |                        |
| North  | 98 FT                            | 0     | EXISTING TO REMAIN             |               |                       |                      |                        |
| East   | 25 FT                            | 0     | EXISTING TO REMAIN             |               |                       |                      |                        |
| West   | 27 FT                            | 0     | EXISTING TO REMAIN             |               |                       |                      |                        |
| South  | 137 FT                           | 0     | EXISTING TO REMAIN             |               |                       |                      |                        |
| Interior   | -                                | 0     | EXISTING TO REMAIN             |               |                       |                      |                        |
| Nonbearing walls and Partitions                          |                                  |       |                                |               |                       |                      |                        |
| Exterior walls   | -                                | 0     | EXISTING TO REMAIN             |               |                       |                      |                        |
| North  | -                                | 0     | EXISTING TO REMAIN             |               |                       |                      |                        |
| East   | -                                | 0     | EXISTING TO REMAIN             |               |                       |                      |                        |
| West   | -                                | 0     | EXISTING TO REMAIN             |               |                       |                      |                        |
| South  | -                                | 0     | EXISTING TO REMAIN             |               |                       |                      |                        |
| Interior walls and partitions                            | -                                | 0     |                                |               |                       |                      |                        |
| Floor Construction including supporting beams and joists | -                                | 0     | EXISTING TO REMAIN             |               |                       |                      |                        |
| Floor / Ceiling Assembly                                 | -                                | 0     | EXISTING TO REMAIN             |               |                       |                      |                        |
| Columns Supporting Floors                                | -                                | 0     | EXISTING TO REMAIN             |               |                       |                      |                        |
| Roof Construction including supporting beams and joists  | -                                | 0     | EXISTING TO REMAIN             |               |                       |                      |                        |
| Roof Ceiling Assembly                                    | -                                | 0     | EXISTING TO REMAIN             |               |                       |                      |                        |
| Columns Supporting Roof                                  | -                                | 0     | EXISTING TO REMAIN             |               |                       |                      |                        |
| Shaft Enclosures - Exit                                  | -                                | 2     | EXISTING TO REMAIN             |               |                       |                      |                        |
| Shaft Enclosures - Other                                 | -                                | 2     |                                |               |                       |                      |                        |
| Corridor Separation                                      | -                                | N/A   |                                |               |                       |                      |                        |
| Occupancy / Fire Barrier Separation                      | -                                | N/A   |                                |               |                       |                      |                        |
| Party/Fire Wall Separation                               | -                                | N/A   |                                |               |                       |                      |                        |
| Smoke Barrier Separation                                 | -                                | N/A   |                                |               |                       |                      |                        |
| Smoke Partition  | -                                | N/A   |                                |               |                       |                      |                        |
| Tenant / Dwelling Unit / Sleeping Unit Separation        | -                                | N/A   |                                |               |                       |                      |                        |
| Incidental Use Separation                                | -                                | N/A   |                                |               |                       |                      |                        |

\* Indicate section number permitting reduction

PERCENTAGE OF WALL OPENING CALCULATIONS

| FIRE SEPARATION DISTANCE<br>(FEET) FROM PROPERTY LINES | DEGREE OF OPENINGS<br>PROTECTION<br>(TABLE 705.8) | PROTECTION (%) |                          |
|--|---|----------------|--------------------------|
| NORTH & SOUTH - GREATER THAN 30'                       | UNPROTECTED, NONSPRINKLERED                       | UNLIMITED      |                          |
| EAST - 25'   | UNPROTECTED, NONSPRINKLERED                       | 70%            | 35% (EXISTING TO REMAIN) |
| WEST - 27'   | UNPROTECTED, NONSPRINKLERED                       | 70%            | 37% (EXISTING TO REMAIN) |

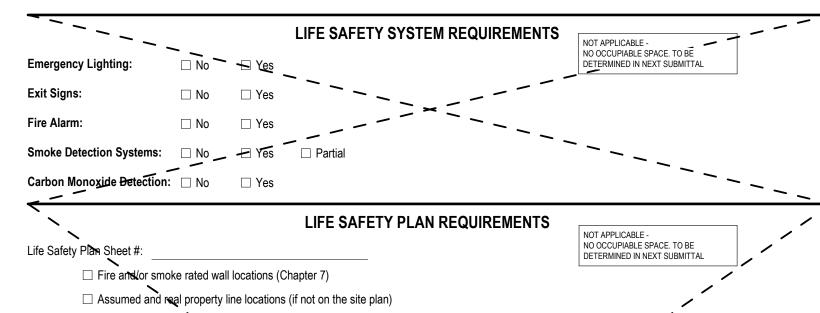

Exterior wall opening area with respect to distance to assumed property lines (705.8) ☐ Occupancy Use for each area as it relates to occupant load calculation (Table 1004.1.2)

☐ Occupant loads for each area ☐ Exit access travel distances (1017) ☐ Common path of travel distances (Tables 1006.2.1 & 1006.3.2(1)) ☐ Dead end lengths (1020.4)

☐ Clear exit widths for each exit door ☐ Maximum calculated occupant load capacity each exit door can accommodate based on egress width (1005.3) ☐ Actual occupant load for each exit door

☐ A separate schematic plan indicating where fire rated floor/ceiling and/or roof structure is provided for purposes of occupancy separation ☐ Location of doors with panic hardware (1010.4.10)

☐ Location of doors with delayed egress locks and the amount of delay (1010.1.9.7) ☐ Location of doors with electromagnetic egress locks (1010.1.9.9) ☐ Location of doors equipped with hold-open devices

☐ Location of emergency escape windows (1030) ☐ The square footage of each fire area (202) The square footage of each smoke compartment for Occupancy Classification I-2 (407.5)

UNITS

MALE FEMALÉ

UNITS

REQUIRED

☐ Note any code exceptions or table notes that may have been utilized regarding the items above ACCESSIBLE DWELLING UNITS TOTAL ACCESSIBLE

PROVIDED

|              | ACCESSIBLE<br>(SECTION    |          |                                 | - NOT APP         | LICABLE -<br>ETERMINED IN NEXT SUBMITTAL |            |
|--------------|---------------------------|----------|---------------------------------|-------------------|--|------------|
|              | TOTAL # OF PARKING SPACES |          | # OF ACCESSIBLE SPACES PROVIDED |                   | TOTAL #                                  |            |
| LOT OR       |                           |          | REGULAR WITH 5'                 | VAN SPACES WITH   |  | ACCESSIBLE |
| PARKING AREA | REQUIRED                  | PROVIDED | ACCESS AISLE                    | 132" ACCESS AISLE | 8' ACCESS AISLE                          | PROVIDED   |
|              |                           | ` '      |                                 |                   |  |            |
|              |                           |          |                                 | /                 |  |            |
| TOTAL        |                           |          | <u> </u>                        | ł                 |  |            |

|   |         | PLUMBING |         | EREQUIRE<br>2902.1) | MENTS   | NOT APPLICABLE |                |          |
|---|---------|----------|---------|---------------------|---------|----------------|----------------|----------|
|   | _       |          | (IADLL) | 2002.1)             | ` \     | DETERMINED IN  | NEXT SUBMITTAL |          |
| ( | OSETS   | URINALS  |         | LAVATORIES          | ,       | SHOWERS        | DRINKING       | FOUNTAIN |
|   | LINISEY |          | MALE    | FEMALE              | LINISEX | ⊀TUBS          | REGIII AR      | ACCESSI  |

UNITS PROVIDED

#### **SPECIAL APPROVALS**

**Special Approval:** (Local Jurisdiction, Department of Insurance, OSC, DPI, DHHS, etc., describe below)

#### **ENERGY SUMMARY**

**ENERGY REQUIREMENTS** The following data shall be considered minimum and any special attribute required to meet the energy code shall also be provided. Each Designer shall furnish the required portions of the project information for the plan data sheet. If performance method, state the annual energy cost for the standard reference design vs annual energy cost for

**Existing building envelope complies with code:** 

No 

Yes (The remainder of this section is not applicable) PER NCEBC 908, ALTERATIONS TO EXISTING RUILDINGS ARE NOT REQUIRED TO C
PROVIDE CODE OF STATUTORY REPORTS OF STATUTORY OF S Method of Compliance: Energy Code - Performance Energy Code - Prescriptive ASHRAE 90.1 - Performance ASHRAE 90.1 - Prescriptive

Other - Performance (Specify source here) THERMAL ENVELOPE (Prescriptive method only) Roof/ceiling Assembly (each assembly) Description of assembly: U-Value of total assembly: R-Value of insulation: Skylights in each assembly:

U-Value of skylight: Total square footage of skylights in each assembly: Exterior Walls (each assembly) Description of assembly: U-Value of total assembly R-Value of insulation: Openings (windows or doors with glazing) U-Value of assembly:

Projection factor: Door R-Values: Walls below grade (each assembly) Description of assembly; U-Value of total assembly: R-Value of insulation: Floors over unconditioned space (each assembly)

Description of assembly: U-Value of total assembly R-Value of insulation: Floors slab on grade Description of assembly:

U-Value of total assembly: R-Value of insulation: Horizontal/vertical requirement: STRUCTURAL DESIGN

(PROVIDE ON THE STRUCTURAL SHEETS IF APPLICABLE) **DESIGN LOADS** SEE STRUCTURAL SHEET S00-01 Importance Factors: Snow  $(I_s)$   $\square$  0.80  $\square$  1.0  $\square$  1.1  $\square$  1.2 Seismic (I<sub>E</sub>) □ 1.0 □ 1.25 □ 1.5 Live Loads:

**Ground Snow Load:** Basic Wind Speed Exposure Category  $\square$  N/A  $\square$  B  $\square$  C  $\square$  D

Seismic Design Category: ☐ N/A ☐ A ☐ B ☐ C Provide the following Seismic Design Parameters: Risk Category (Table 1604.5) 

N/A 

I 

II 

III 

IV Spectral Response Acceleration: S<sub>s</sub> \_\_\_\_\_\_%g S<sub>1</sub> \_\_\_\_\_\_%g Site Classification (ASCE 7):  $\square$  N/A  $\square$  A  $\square$  B  $\square$  C  $\square$  D  $\square$  E  $\square$  F

Data Source: ☐ N/A ☐ Field Test ☐ Presumptive ☐ Historical Data Basic structural system: ☐ N/A ☐ Bearing Wall ☐ Building Frame ☐ Moment Frame ☐ Dual w/ Special Moment Frame ☐ Dual w/ Intermediate R/C or Special Steel ☐ Inverted Pendulum

MECHANICAL DESIGN

**SEISMIC DESIGN** 

SEE STRUCTURAL SHEET S00-01

Analysis Procedure: ☐ N/A ☐ Simplified ☐ Equivalent Lateral Force ☐ Dynamic Architectural, Mechanical, Components anchored? ☐ N/A ☐ Yes ☐ No

Lateral Design Control: ☐ N/A ☐ Earthquake ☐ Wind Soil Bearing Capacities: 

N/A Field Test (Provide copy of test report) 

Presumptive Bearing Capacity \_\_\_ Pile size, type, and capacity:

(PROVIDE ON THE MECHANICAL SHEETS IF APPLICABLE) **MECHANICAL SYSTEMS, SERVICE SYSTEMS, & EQUIPMENT** Thermal zone: winter dry bulb: summer dry bulb: Interior design conditions: winter dry bulb: NO OCCUPIABLE SPACE PROPOSED IN summer dry bulb: THIS PHASE. SEE MECHANICAL SHEETS. relative humidity: Building heating load: Building cooling load: Mechanical Spacing Conditioning System description of unit: heating efficiency: cooling efficiency: size category of unit: Size category. If oversized, state reason Size category. If oversized, state reason: List equipment efficiencies:

**ELECTRICAL DESIGN** 

**ELECTRICAL SYSTEM & EQUIPMENT** Method of Compliance: ☐ N/A ☐ Energy Code - Prescriptive ☐ Energy Code - Performance ☐ ASHRAE 90.1 Prescriptive ☐ ASHRAE 90.1 - Performance Lighting schedule (each fixture type) lamp type required in fixture number of lamps in fixture ballast type used in the fixture number of ballasts in fixture total wattage per fixture NO OCCUPIABLE SPACE PROPOSED IN total interior wattage specified vs. allowed (whole building of space by space) THIS PHASE. SEE ELECTRICAL SHEETS. total exterior wattage specified vs. allowed

Additional Efficiency Package Options (When using the 2018 NCECC; not required for ASHRAE 90.1) C406.2 More Efficient HVAC Equipment Performa

C406.3 Reduced Lighting Power Density C406 4 Enhanced Digital Lighting Controls C406.5 On-Site Renewable Energy C406.6 Dedicated Outdoor Air System ☐ C406.7 Reduced Energy Use in Service Water Heating

#### Perkins&Will

411 W. Chapel Hill Street Durham, NC 27701 t 919.433.5300

#### www.perkinswill.com

CONSULTANTS

AUDIO/VISUAL

Lynch Mykins Structural Engineers 301 N. West Street Suite 105, Raleigh, NC 27603

> Salas O'Brien 702 Oberlin Road, Raleigh, NC 27605 License (NC): F-1434

NV5 Engineers and Consultants 3300 Regency Parkway Suite 100, Cary, NC 27518

Holder Construction Group 6210 Ardrey Kell Road Suite 400, Charlotte, NC 28277

NV5 Engineers and Consultants 4905 Professional Court, Raleigh, NC 27609

Available Light 5700 Six Forks Road, Suite 203, Raleigh, NC 27609

SUSTAINABILITY **Ecoimpact Consulting** 8022 Providence Road Suite 500, Charlotte, NC 28277





Mann Hall Renovation STATE ID #22-24500-02B NCSU PROJECT # 202220021



**North Carolina State** University Facilities Division Design & Construction Administrative Services Building III 2601 Wolf Village Way, Suite 331 Raleigh, NC 27695



**ISSUE CHART** 

ISSUE FOR BID - PROC 01/17/2025 ISSUE FOR BID - DEMO REV 1 10/28/2024 ISSUE FOR BID - DEMO 4/17/2024 820937.001 Author Checker

TITLE **CODE COMPLIANCE** 


SHEET NUMBER


**DATA - DEMOLITION** 

**G01-01** 

Copyright © 2024 Perkins+Will

Approver

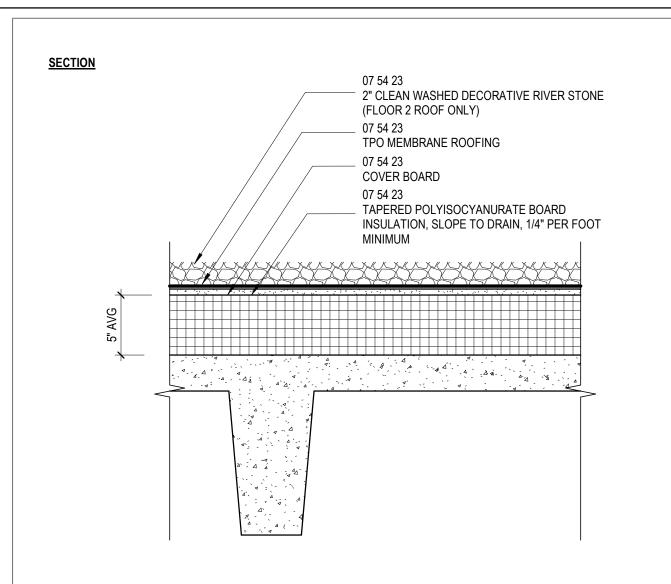

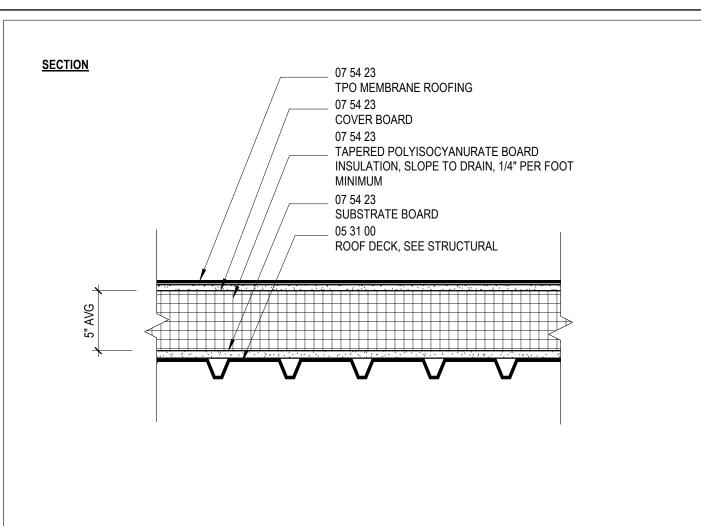

## RF212 ROOF ASSEMBLY TPO ROOF MEMBRANE OVER POLYISO INSUL AND CAST-IN-PLACE CONCRETE

| MARK    | DESCRIPTION   |
|---------|---|
| RF212A  | TPO ROOF MEMBRANE OVER POLYISO INSUL, CAST-IN-PLACE CONCRETE                      |
| RF212B  | TPO ROOF MEMBRANE OVER POLYISO INSUL, CAST-IN-PLACE CONCRETE, AND 2" CLEAN GRAVEL |
|         |   |
| R-VALUE |   |
| 0.21    | OUTSIDE AIR FILM  |
| 0.45    | COVER BOARD   |
| 28.00   | 5" POLYISOCYANURATE BOARD INSULATION  |
| 0.56    | SUBSTRATE BOARD   |
| 0.34    | COMPOSITE ROOF DECK   |
| 0.68    | INSIDE AIR FILM   |
| 30.24   |   |

## RF211 ROOF ASSEMBLY TPO ROOF MEMBRANE OVER POLYISO INSUL AND STEEL DECK

| MARK    | DESCRIPTION   |
|---------|---|
| RF221   | TPO ROOF MEMBRANE OVER POLYISO INSUL AND STEEL DECK |
|         |   |
|         |   |
|         |   |
| R-VALUE |   |
| 0.21    | OUTSIDE AIR FILM                                    |
| 0.45    | COVER BOARD   |
| 28.00   | 5" POLYISOCYANURATE BOARD INSULATION (5.6/IN)       |
| 0.56    | SUBSTRATE BOARD                                     |
| 0.00    | METAL DECK  |
| 0.68    | INSIDE AIR FILM                                     |
| 29.90   |   |

### Perkins&Will

Legacy Tower 411 W Chapel Hill Street, Suite 200 Durham, North Carolina 27701 t 919.433.5300 f 919.433.5301 www.perkinswill.com

## **CONSULTANTS**

Lynch Mykins Structural Engineers 301 N. West Street Suite 105, Raleigh, NC 27603

> Salas O'Brien 702 Oberlin Road, Raleigh, NC 27605 License (NC): F-1434

NV5 Engineers and Consultants 3300 Regency Parkway Suite 100, Cary, NC 27518

Holder Construction Group 6210 Ardrey Kell Road Suite 400, Charlotte, NC 28277

NV5 Engineers and Consultants 4905 Professional Court, Raleigh, NC 27609

Available Light 5700 Six Forks Road, Suite 203, Raleigh, NC 27609

SUSTAINABILITY **Ecoimpact Consulting** 

8022 Providence Road Suite 500, Charlotte, NC 28277

**Mann Hall Renovation** STATE ID #22-24500-02B NCSU PROJECT # 202220021



**North Carolina State** University Facilities Division Design & Construction Administrative Services Building III 2601 Wolf Village Way, Suite 331 Raleigh, NC 27695




820937.001 Job Number Author Approver TITLE

> **EXTERIOR ASSEMBLIES**

> > SHEET NUMBER

A00-10

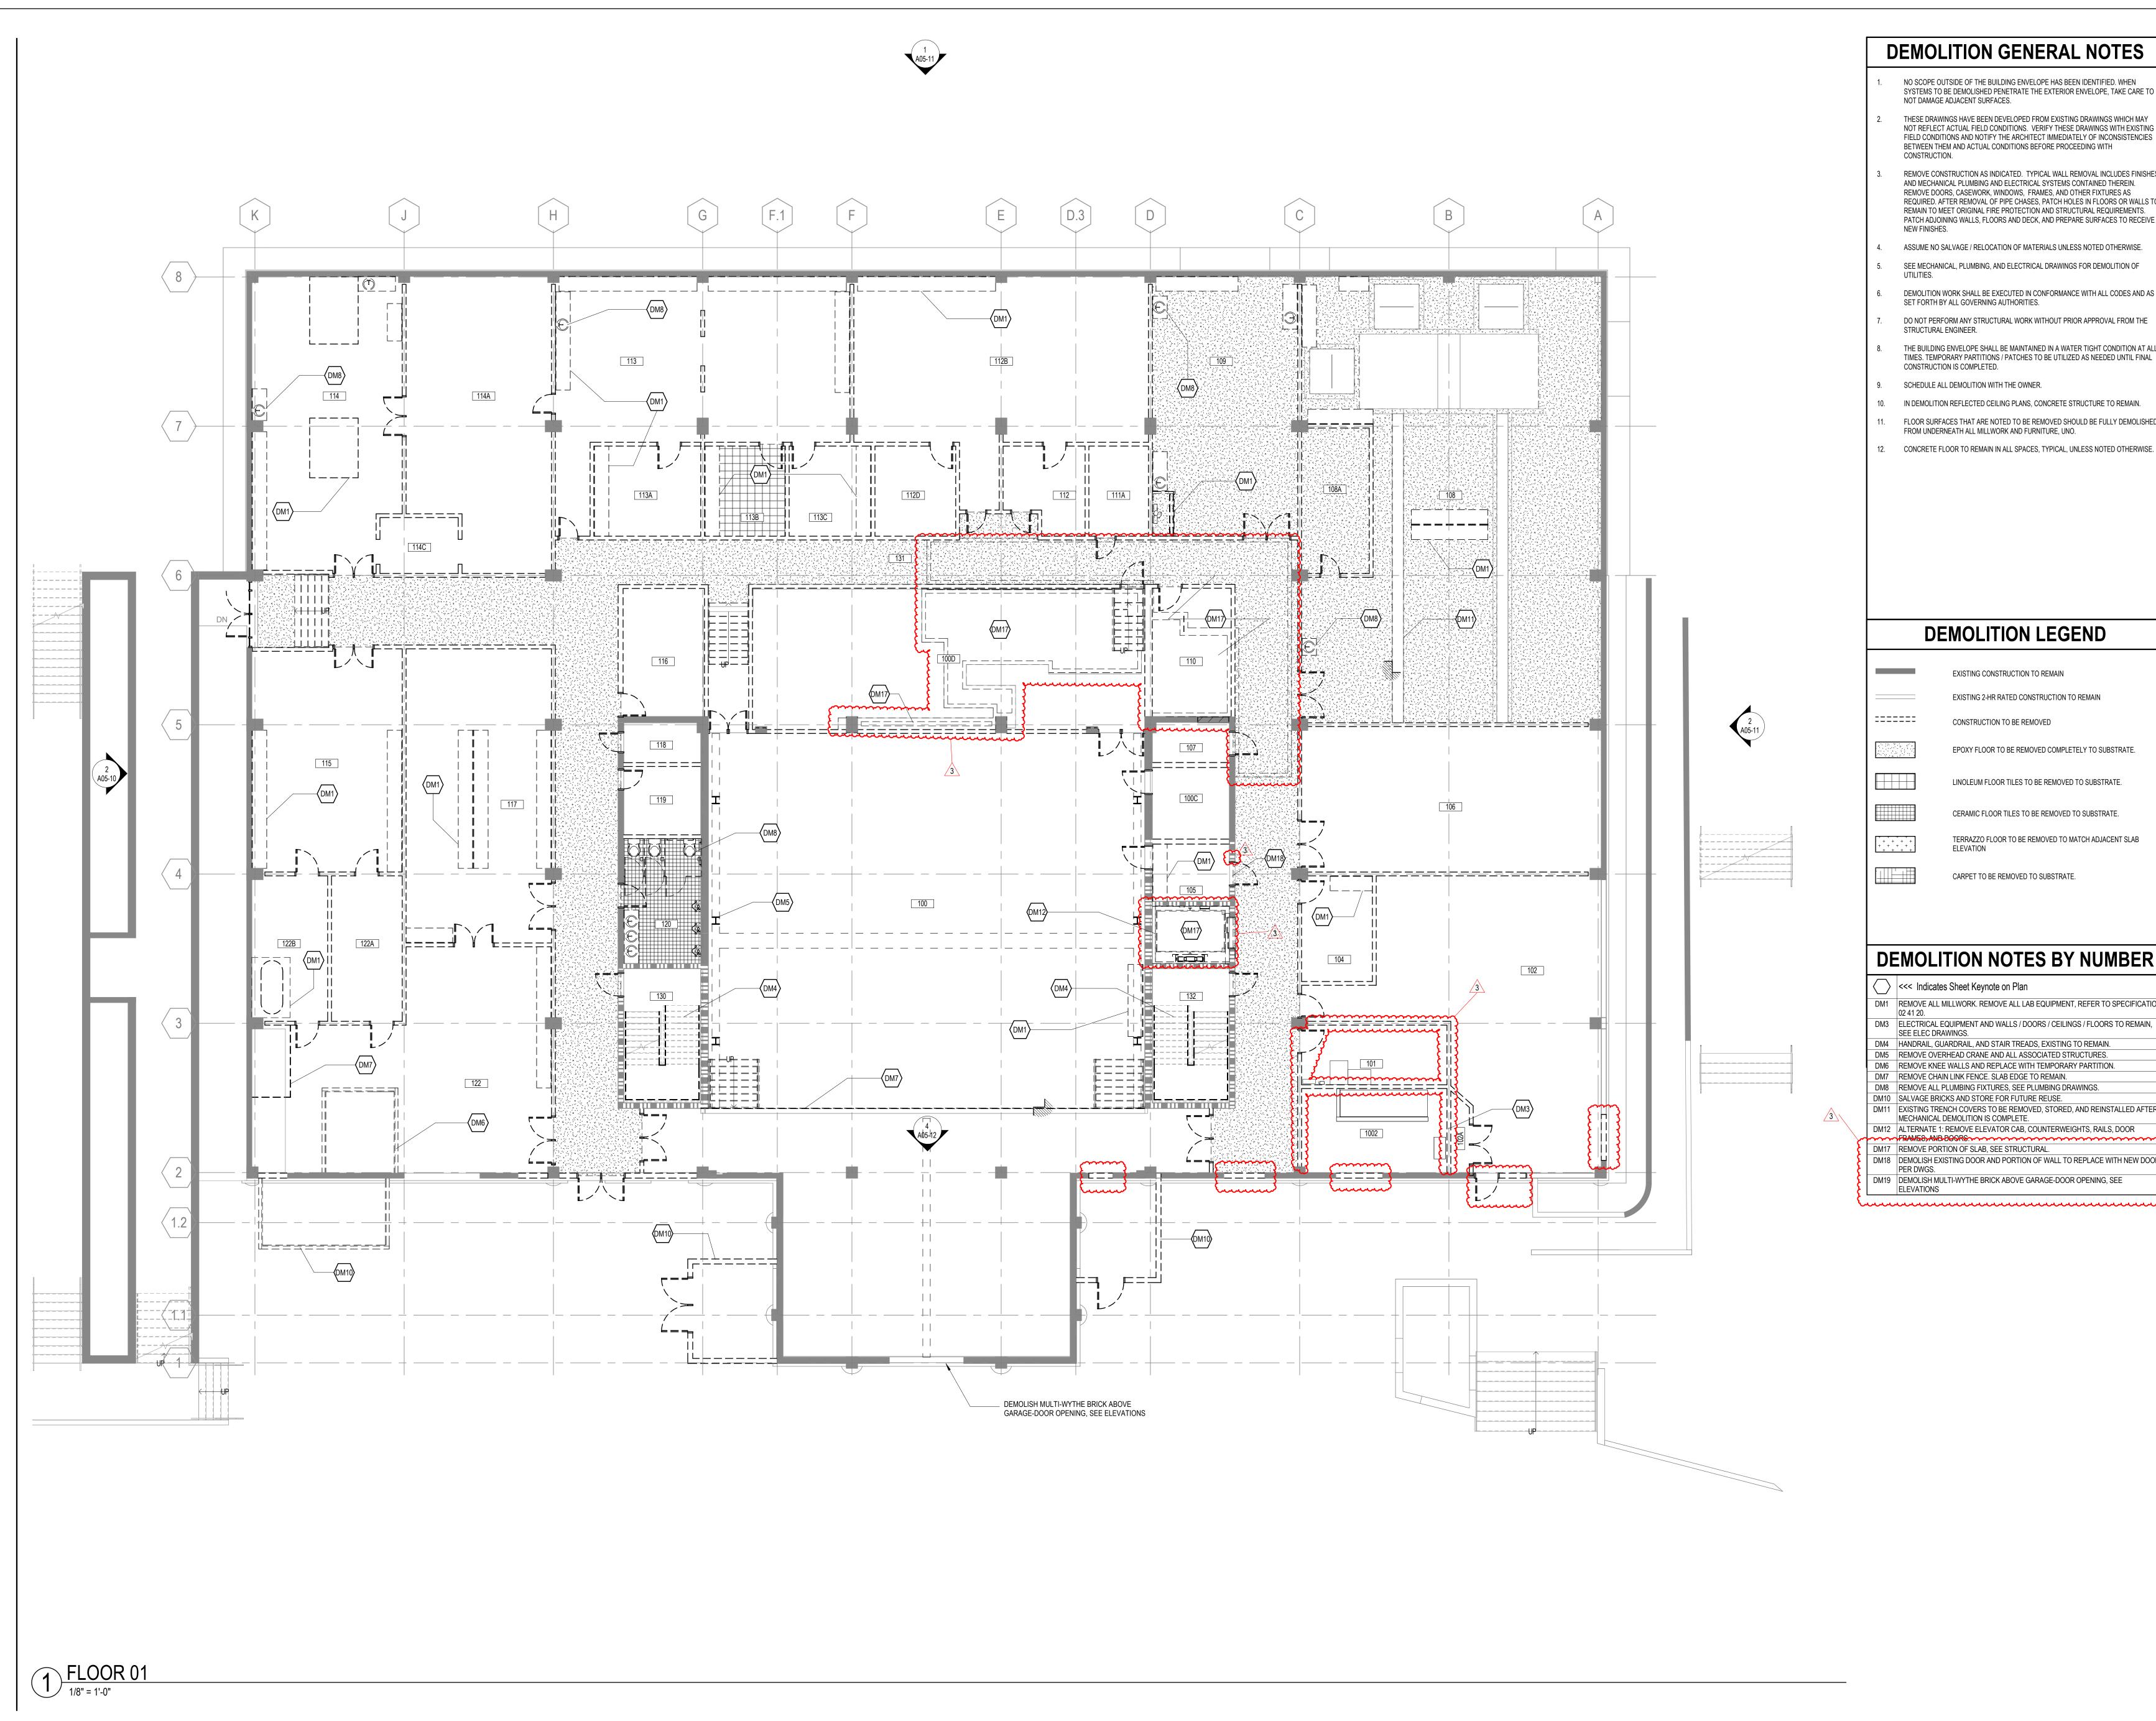

#### **DEMOLITION GENERAL NOTES**

NO SCOPE OUTSIDE OF THE BUILDING ENVELOPE HAS BEEN IDENTIFIED. WHEN SYSTEMS TO BE DEMOLISHED PENETRATE THE EXTERIOR ENVELOPE, TAKE CARE TO NOT DAMAGE ADJACENT SURFACES.

THESE DRAWINGS HAVE BEEN DEVELOPED FROM EXISTING DRAWINGS WHICH MAY NOT REFLECT ACTUAL FIELD CONDITIONS. VERIFY THESE DRAWINGS WITH EXISTING FIELD CONDITIONS AND NOTIFY THE ARCHITECT IMMEDIATELY OF INCONSISTENCIES BETWEEN THEM AND ACTUAL CONDITIONS BEFORE PROCEEDING WITH

REMOVE CONSTRUCTION AS INDICATED. TYPICAL WALL REMOVAL INCLUDES FINISHES AND MECHANICAL PLUMBING AND ELECTRICAL SYSTEMS CONTAINED THEREIN. REMOVE DOORS, CASEWORK, WINDOWS, FRAMES, AND OTHER FIXTURES AS REQUIRED. AFTER REMOVAL OF PIPE CHASES, PATCH HOLES IN FLOORS OR WALLS TO REMAIN TO MEET ORIGINAL FIRE PROTECTION AND STRUCTURAL REQUIREMENTS. PATCH ADJOINING WALLS, FLOORS AND DECK, AND PREPARE SURFACES TO RECEIVE

ASSUME NO SALVAGE / RELOCATION OF MATERIALS UNLESS NOTED OTHERWISE.

SEE MECHANICAL, PLUMBING, AND ELECTRICAL DRAWINGS FOR DEMOLITION OF

DEMOLITION WORK SHALL BE EXECUTED IN CONFORMANCE WITH ALL CODES AND AS SET FORTH BY ALL GOVERNING AUTHORITIES.

DO NOT PERFORM ANY STRUCTURAL WORK WITHOUT PRIOR APPROVAL FROM THE STRUCTURAL ENGINEER.

THE BUILDING ENVELOPE SHALL BE MAINTAINED IN A WATER TIGHT CONDITION AT ALL TIMES. TEMPORARY PARTITIONS / PATCHES TO BE UTILIZED AS NEEDED UNTIL FINAL CONSTRUCTION IS COMPLETED.

SCHEDULE ALL DEMOLITION WITH THE OWNER.

10. IN DEMOLITION REFLECTED CEILING PLANS, CONCRETE STRUCTURE TO REMAIN. FLOOR SURFACES THAT ARE NOTED TO BE REMOVED SHOULD BE FULLY DEMOLISHED

12. CONCRETE FLOOR TO REMAIN IN ALL SPACES, TYPICAL, UNLESS NOTED OTHERWISE.

Perkins&Will

411 W. Chapel Hill Street Durham, NC 27701 t 919.433.5300 www.perkinswill.com

CONSULTANTS

STRUCTURAL Lynch Mykins Structural Engineers 301 N. West Street Suite 105, Raleigh, NC 27603

> Salas O'Brien 702 Oberlin Road, Raleigh, NC 27605 License (NC): F-1434

NV5 Engineers and Consultants 3300 Regency Parkway Suite 100, Cary, NC 27518

Holder Construction Group

6210 Ardrey Kell Road Suite 400, Charlotte, NC 28277

NV5 Engineers and Consultants 4905 Professional Court, Raleigh, NC 27609

Available Light 5700 Six Forks Road, Suite 203, Raleigh, NC 27609

SUSTAINABILITY **Ecoimpact Consulting** 8022 Providence Road Suite 500, Charlotte, NC 28277

**DEMOLITION LEGEND** 

EXISTING CONSTRUCTION TO REMAIN

EXISTING 2-HR RATED CONSTRUCTION TO REMAIN

CONSTRUCTION TO BE REMOVED

EPOXY FLOOR TO BE REMOVED COMPLETELY TO SUBSTRATE.

LINOLEUM FLOOR TILES TO BE REMOVED TO SUBSTRATE.

CERAMIC FLOOR TILES TO BE REMOVED TO SUBSTRATE.

TERRAZZO FLOOR TO BE REMOVED TO MATCH ADJACENT SLAB **ELEVATION** 

CARPET TO BE REMOVED TO SUBSTRATE.

#### **DEMOLITION NOTES BY NUMBER**

<<< Indicates Sheet Keynote on Plan</p>

DM1 REMOVE ALL MILLWORK. REMOVE ALL LAB EQUIPMENT, REFER TO SPECIFICATION

DM3 | ELECTRICAL EQUIPMENT AND WALLS / DOORS / CEILINGS / FLOORS TO REMAIN, SEE ELEC DRAWINGS.

DM4 HANDRAIL, GUARDRAIL, AND STAIR TREADS, EXISTING TO REMAIN.

DM5 REMOVE OVERHEAD CRANE AND ALL ASSOCIATED STRUCTURES.

DM6 REMOVE KNEE WALLS AND REPLACE WITH TEMPORARY PARTITION. DM7 REMOVE CHAIN LINK FENCE. SLAB EDGE TO REMAIN.

DM10 | SALVAGE BRICKS AND STORE FOR FUTURE REUSE.

DM11 EXISTING TRENCH COVERS TO BE REMOVED, STORED, AND REINSTALLED AFTER MECHANICAL DEMOLITION IS COMPLETE.

DM12 | ALTERNATE 1: REMOVE ELEVATOR CAB, COUNTERWEIGHTS, RAILS, DOOR

DM18 DEMOLISH EXISTING DOOR AND PORTION OF WALL TO REPLACE WITH NEW DOOR

DM19 DEMOLISH MULTI-WYTHE BRICK ABOVE GARAGE-DOOR OPENING, SEE ELEVATIONS



Mann Hall Renovation STATE ID #22-24500-02B NCSU PROJECT # 202220021

**North Carolina State** University Facilities Division Design & Construction Administrative Services Building III

2601 Wolf Village Way, Suite 331

Raleigh, NC 27695

**ISSUE CHART** 


ISSUE FOR BID - PROC 01/17/2025 ISSUE FOR BID - DEMO REV 1 10/28/2024 ISSUE FOR BID - DEMO 4/17/2024 820937.001 Approver

**DEMOLITION PLAN** FLOOR 01

SHEET NUMBER

TITLE

A04-01

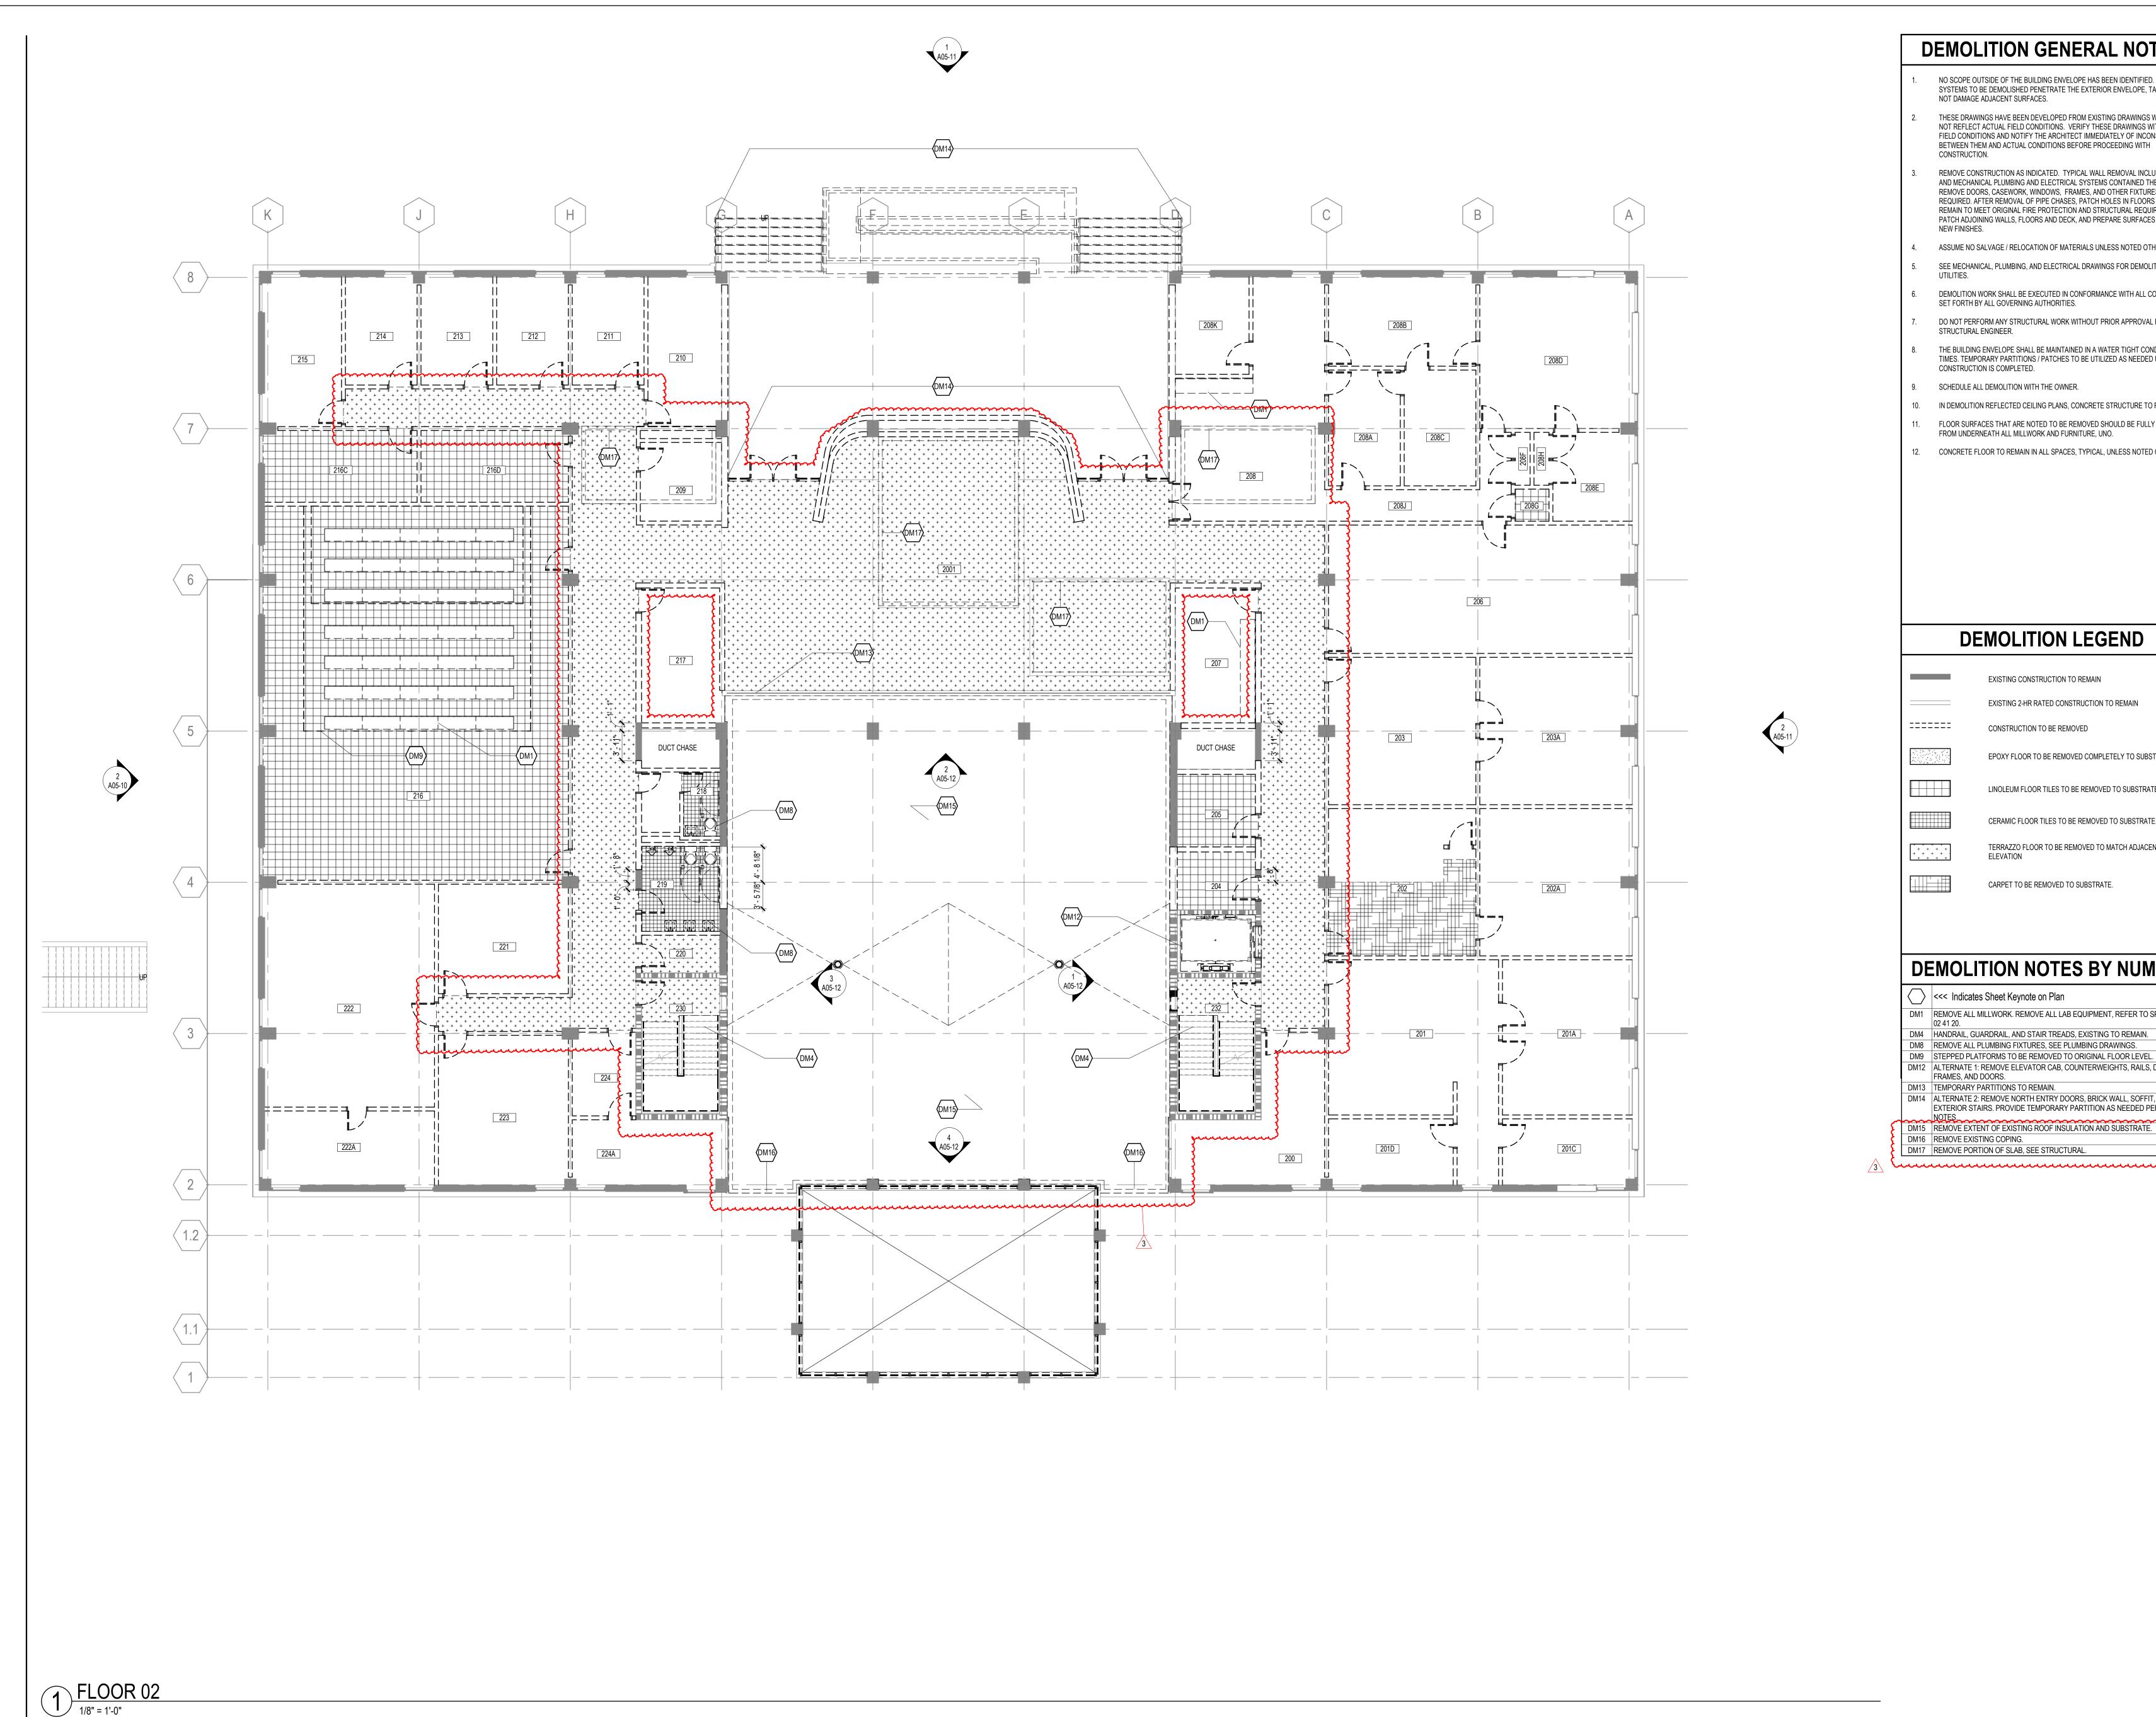

#### **DEMOLITION GENERAL NOTES** Perkins&Will

NO SCOPE OUTSIDE OF THE BUILDING ENVELOPE HAS BEEN IDENTIFIED. WHEN SYSTEMS TO BE DEMOLISHED PENETRATE THE EXTERIOR ENVELOPE, TAKE CARE TO NOT DAMAGE ADJACENT SURFACES.

THESE DRAWINGS HAVE BEEN DEVELOPED FROM EXISTING DRAWINGS WHICH MAY NOT REFLECT ACTUAL FIELD CONDITIONS. VERIFY THESE DRAWINGS WITH EXISTING FIELD CONDITIONS AND NOTIFY THE ARCHITECT IMMEDIATELY OF INCONSISTENCIES BETWEEN THEM AND ACTUAL CONDITIONS BEFORE PROCEEDING WITH

REMOVE CONSTRUCTION AS INDICATED. TYPICAL WALL REMOVAL INCLUDES FINISHES AND MECHANICAL PLUMBING AND ELECTRICAL SYSTEMS CONTAINED THEREIN. REMOVE DOORS, CASEWORK, WINDOWS, FRAMES, AND OTHER FIXTURES AS REQUIRED. AFTER REMOVAL OF PIPE CHASES, PATCH HOLES IN FLOORS OR WALLS TO REMAIN TO MEET ORIGINAL FIRE PROTECTION AND STRUCTURAL REQUIREMENTS. PATCH ADJOINING WALLS, FLOORS AND DECK, AND PREPARE SURFACES TO RECEIVE

- ASSUME NO SALVAGE / RELOCATION OF MATERIALS UNLESS NOTED OTHERWISE.
- SEE MECHANICAL, PLUMBING, AND ELECTRICAL DRAWINGS FOR DEMOLITION OF
- DEMOLITION WORK SHALL BE EXECUTED IN CONFORMANCE WITH ALL CODES AND AS SET FORTH BY ALL GOVERNING AUTHORITIES. DO NOT PERFORM ANY STRUCTURAL WORK WITHOUT PRIOR APPROVAL FROM THE
- STRUCTURAL ENGINEER. THE BUILDING ENVELOPE SHALL BE MAINTAINED IN A WATER TIGHT CONDITION AT ALL
- TIMES. TEMPORARY PARTITIONS / PATCHES TO BE UTILIZED AS NEEDED UNTIL FINAL CONSTRUCTION IS COMPLETED.
- SCHEDULE ALL DEMOLITION WITH THE OWNER.
- 10. IN DEMOLITION REFLECTED CEILING PLANS, CONCRETE STRUCTURE TO REMAIN.
- FLOOR SURFACES THAT ARE NOTED TO BE REMOVED SHOULD BE FULLY DEMOLISHED FROM UNDERNEATH ALL MILLWORK AND FURNITURE, UNO.
- 12. CONCRETE FLOOR TO REMAIN IN ALL SPACES, TYPICAL, UNLESS NOTED OTHERWISE.

#### NV5 Engineers and Consultants 3300 Regency Parkway Suite 100, Cary, NC 27518

Holder Construction Group 6210 Ardrey Kell Road Suite 400, Charlotte, NC 28277

411 W. Chapel Hill Street

Durham, NC 27701

www.perkinswill.com

CONSULTANTS

Lynch Mykins Structural Engineers

702 Oberlin Road, Raleigh, NC 27605

301 N. West Street Suite 105, Raleigh, NC 27603

t 919.433.5300

Salas O'Brien

License (NC): F-1434

NV5 Engineers and Consultants

4905 Professional Court, Raleigh, NC 27609

Available Light 5700 Six Forks Road, Suite 203, Raleigh, NC 27609

SUSTAINABILITY **Ecoimpact Consulting** 8022 Providence Road Suite 500, Charlotte, NC 28277

#### **DEMOLITION LEGEND**

EXISTING CONSTRUCTION TO REMAIN

EXISTING 2-HR RATED CONSTRUCTION TO REMAIN

CONSTRUCTION TO BE REMOVED

EPOXY FLOOR TO BE REMOVED COMPLETELY TO SUBSTRATE.

LINOLEUM FLOOR TILES TO BE REMOVED TO SUBSTRATE.

CERAMIC FLOOR TILES TO BE REMOVED TO SUBSTRATE.

TERRAZZO FLOOR TO BE REMOVED TO MATCH ADJACENT SLAB **ELEVATION** 

CARPET TO BE REMOVED TO SUBSTRATE.

#### **DEMOLITION NOTES BY NUMBER**

<<< Indicates Sheet Keynote on Plan</p>

DM1 REMOVE ALL MILLWORK. REMOVE ALL LAB EQUIPMENT, REFER TO SPECIFICATION


DM4 HANDRAIL, GUARDRAIL, AND STAIR TREADS, EXISTING TO REMAIN.

DM8 REMOVE ALL PLUMBING FIXTURES, SEE PLUMBING DRAWINGS. DM9 STEPPED PLATFORMS TO BE REMOVED TO ORIGINAL FLOOR LEVEL DM12 | ALTERNATE 1: REMOVE ELEVATOR CAB, COUNTERWEIGHTS, RAILS, DOOR

FRAMES, AND DOORS. DM13 TEMPORARY PARTITIONS TO REMAIN. DM14 ALTERNATE 2: REMOVE NORTH ENTRY DOORS, BRICK WALL, SOFFIT, RAMP, AND

EXTERIOR STAIRS. PROVIDE TEMPORARY PARTITION AS NEEDED PER GENERAL

DM15 REMOVE EXTENT OF EXISTING ROOF INSULATION AND SUBSTRATE DM16 REMOVE EXISTING COPING. DM17 REMOVE PORTION OF SLAB, SEE STRUCTURAL.

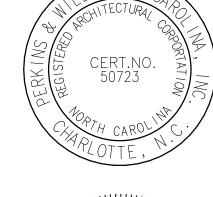



Mann Hall Renovation STATE ID #22-24500-02B NCSU PROJECT # 202220021



**North Carolina State** University Facilities Division Design & Construction Administrative Services Building III 2601 Wolf Village Way, Suite 331 Raleigh, NC 27695



**ISSUE CHART** 

ISSUE FOR BID - PROC 01/17/2025 ISSUE FOR BID - DEMO REV 1 10/28/2024 ISSUE FOR BID - DEMO 4/17/2024 820937.001 Approver


**DEMOLITION PLAN -**FLOOR 02

SHEET NUMBER

TITLE

A04-02



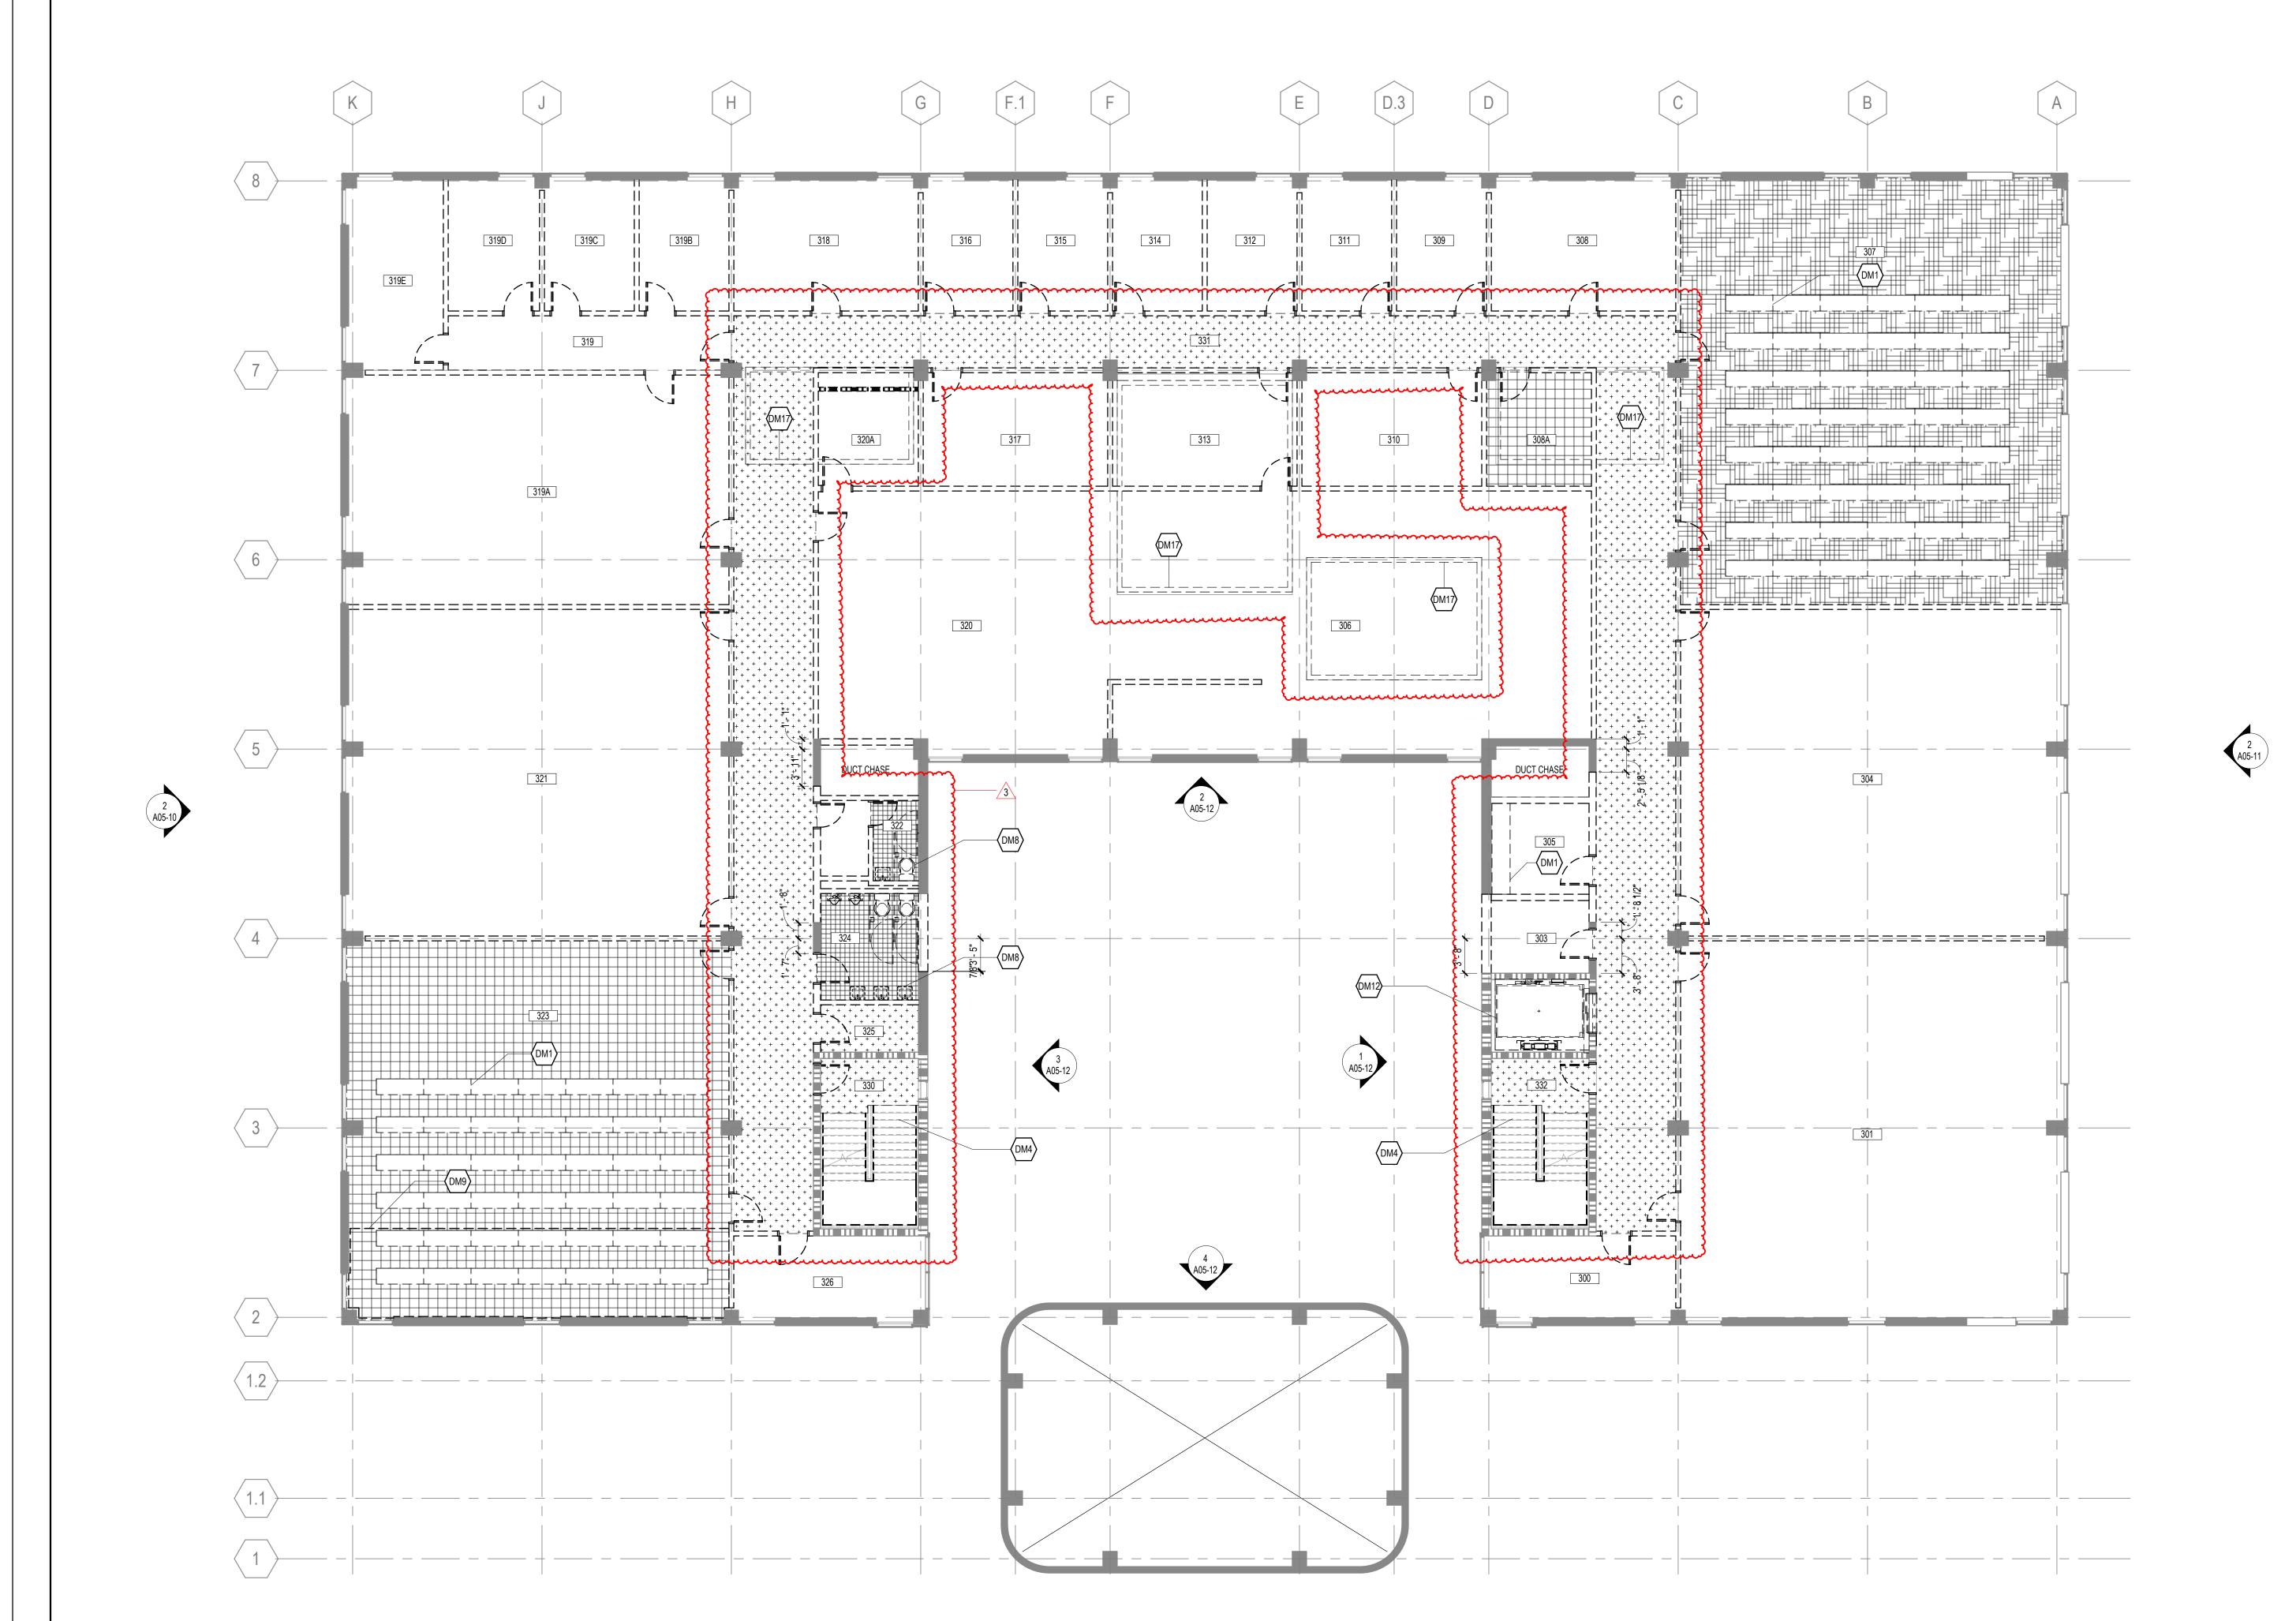

#### DEMOLITION GENERAL NOTES

NO SCOPE OUTSIDE OF THE BUILDING ENVELOPE HAS BEEN IDENTIFIED. WHEN
SYSTEMS TO BE DEMOLISHED PENETRATE THE EXTERIOR ENVELOPE, TAKE CARE TO
NOT DAMAGE ADJACENT SURFACES.

- 2. THESE DRAWINGS HAVE BEEN DEVELOPED FROM EXISTING DRAWINGS WHICH MAY NOT REFLECT ACTUAL FIELD CONDITIONS. VERIFY THESE DRAWINGS WITH EXISTING FIELD CONDITIONS AND NOTIFY THE ARCHITECT IMMEDIATELY OF INCONSISTENCIES BETWEEN THEM AND ACTUAL CONDITIONS BEFORE PROCEEDING WITH CONSTRUCTION
- REMOVE CONSTRUCTION AS INDICATED. TYPICAL WALL REMOVAL INCLUDES FINISHES AND MECHANICAL PLUMBING AND ELECTRICAL SYSTEMS CONTAINED THEREIN.
  REMOVE DOORS, CASEWORK, WINDOWS, FRAMES, AND OTHER FIXTURES AS REQUIRED. AFTER REMOVAL OF PIPE CHASES, PATCH HOLES IN FLOORS OR WALLS TO REMAIN TO MEET ORIGINAL FIRE PROTECTION AND STRUCTURAL REQUIREMENTS.
  PATCH ADJOINING WALLS, FLOORS AND DECK, AND PREPARE SURFACES TO RECEIVE
- 4. ASSUME NO SALVAGE / RELOCATION OF MATERIALS UNLESS NOTED OTHERWISE.
- 5. SEE MECHANICAL, PLUMBING, AND ELECTRICAL DRAWINGS FOR DEMOLITION OF UTILITIES.
- 6. DEMOLITION WORK SHALL BE EXECUTED IN CONFORMANCE WITH ALL CODES AND AS SET FORTH BY ALL GOVERNING AUTHORITIES.
- DO NOT PERFORM ANY STRUCTURAL WORK WITHOUT PRIOR APPROVAL FROM THE STRUCTURAL ENGINEER.
   THE BUILDING ENVELOPE SHALL BE MAINTAINED IN A WATER TIGHT CONDITION AT ALL
- TIMES. TEMPORARY PARTITIONS / PATCHES TO BE UTILIZED AS NEEDED UNTIL FINAL CONSTRUCTION IS COMPLETED.
- 9. SCHEDULE ALL DEMOLITION WITH THE OWNER.
- 10. IN DEMOLITION REFLECTED CEILING PLANS, CONCRETE STRUCTURE TO REMAIN.
   11. FLOOR SURFACES THAT ARE NOTED TO BE REMOVED SHOULD BE FULLY DEMOLISHED
- FROM UNDERNEATH ALL MILLWORK AND FURNITURE, UNO.
- 12. CONCRETE FLOOR TO REMAIN IN ALL SPACES, TYPICAL, UNLESS NOTED OTHERWISE.

#### **DEMOLITION LEGEND**

EXISTING CONSTRUCTION TO REMAIN

EXISTING 2-HR RATED CONSTRUCTION TO REMAIN

EPOXY FLOOR TO BE REMOVED COMPLETELY TO SUBSTRATE.

CONSTRUCTION TO BE REMOVED

LINOLEUM FLOOR TILES TO BE REMOVED TO SUBSTRATE.

CERAMIC FLOOR TILES TO BE REMOVED TO SUBSTRATE.

TERRAZZO FLOOR TO BE REMOVED TO MATCH ADJACENT SLAB

+ + + + + + + | TERRAZZO FLOOR TO BE REMOVED TO MATCH ADJACE ELEVATION

CARPET TO BE REMOVED TO SUBSTRATE.

DEMOLITION NOTES BY NUMBER

<--- Indicates Sheet Keynote on Plan</p>

DM1 REMOVE ALL MILLWORK. REMOVE ALL LAB EQUIPMENT, REFER TO SPECIFICATION

DM4 HANDRAIL, GUARDRAIL, AND STAIR TREADS, EXISTING TO REMAIN.

DM8 REMOVE ALL PLUMBING FIXTURES, SEE PLUMBING DRAWINGS.

DM9 STEPPED PLATFORMS TO BE REMOVED TO ORIGINAL FLOOR LEVEL.

DM12 ALTERNATE 1: REMOVE ELEVATOR CAB, COUNTERWEIGHTS, RAILS, DOOR
FRAMES, AND DOORS.

DM17 REMOVE PORTION OF SLAB, SEE STRUCTURAL.

### Perkins&Will

411 W. Chapel Hill Street Suite 200 Durham, NC 27701 t 919.433.5300 www.perkinswill.com

CONSULTANTS

STRUCTURAL

Lynch Mykins Structural Engineers

301 N. West Street Suite 105, Raleigh, NC 27603

Salas O'Brien 702 Oberlin Road, Raleigh, NC 27605 License (NC): F-1434

NV5 Engineers and Consultants

3300 Regency Parkway Suite 100, Cary, NC 27518

CONTRACTOR

Holder Construction Group 6210 Ardrey Kell Road Suite 400, Charlotte, NC 28277

> NV5 Engineers and Consultants 4905 Professional Court, Raleigh, NC 27609

центіме Available Light

5700 Six Forks Road, Suite 203, Raleigh, NC 27609

SUSTAINABILITY

Ecoimpact Consulting 8022 Providence Road Suite 500, Charlotte, NC 28277





Mann Hall Renovation

STATE ID #22-24500-02B

NCSU PROJECT # 202220021



North Carolina State
University
Facilities Division Design & Construction
Administrative Services Building III
2601 Wolf Village Way, Suite 331

Raleigh, NC 27695



ISSUE CHART

| Appro | ved                        | Approve    |
|-------|----------------------------|------------|
| Check | red                        | Checker    |
| Drawr | 1                          | Author     |
| Job N | umber 82                   | 20937.001  |
| MARK  | ISSUE                      | DATE       |
| 1     | ISSUE FOR BID - DEMO       | 4/17/2024  |
| 2     | ISSUE FOR BID - DEMO REV 1 | 10/28/2024 |
| 3     | ISSUE FOR BID - PROC       | 01/17/2025 |

DEMOLITION PLAN -FLOOR 03


SHEET NUMBER

A04-03

1 FLOOR 03

1/8" = 1'-0"



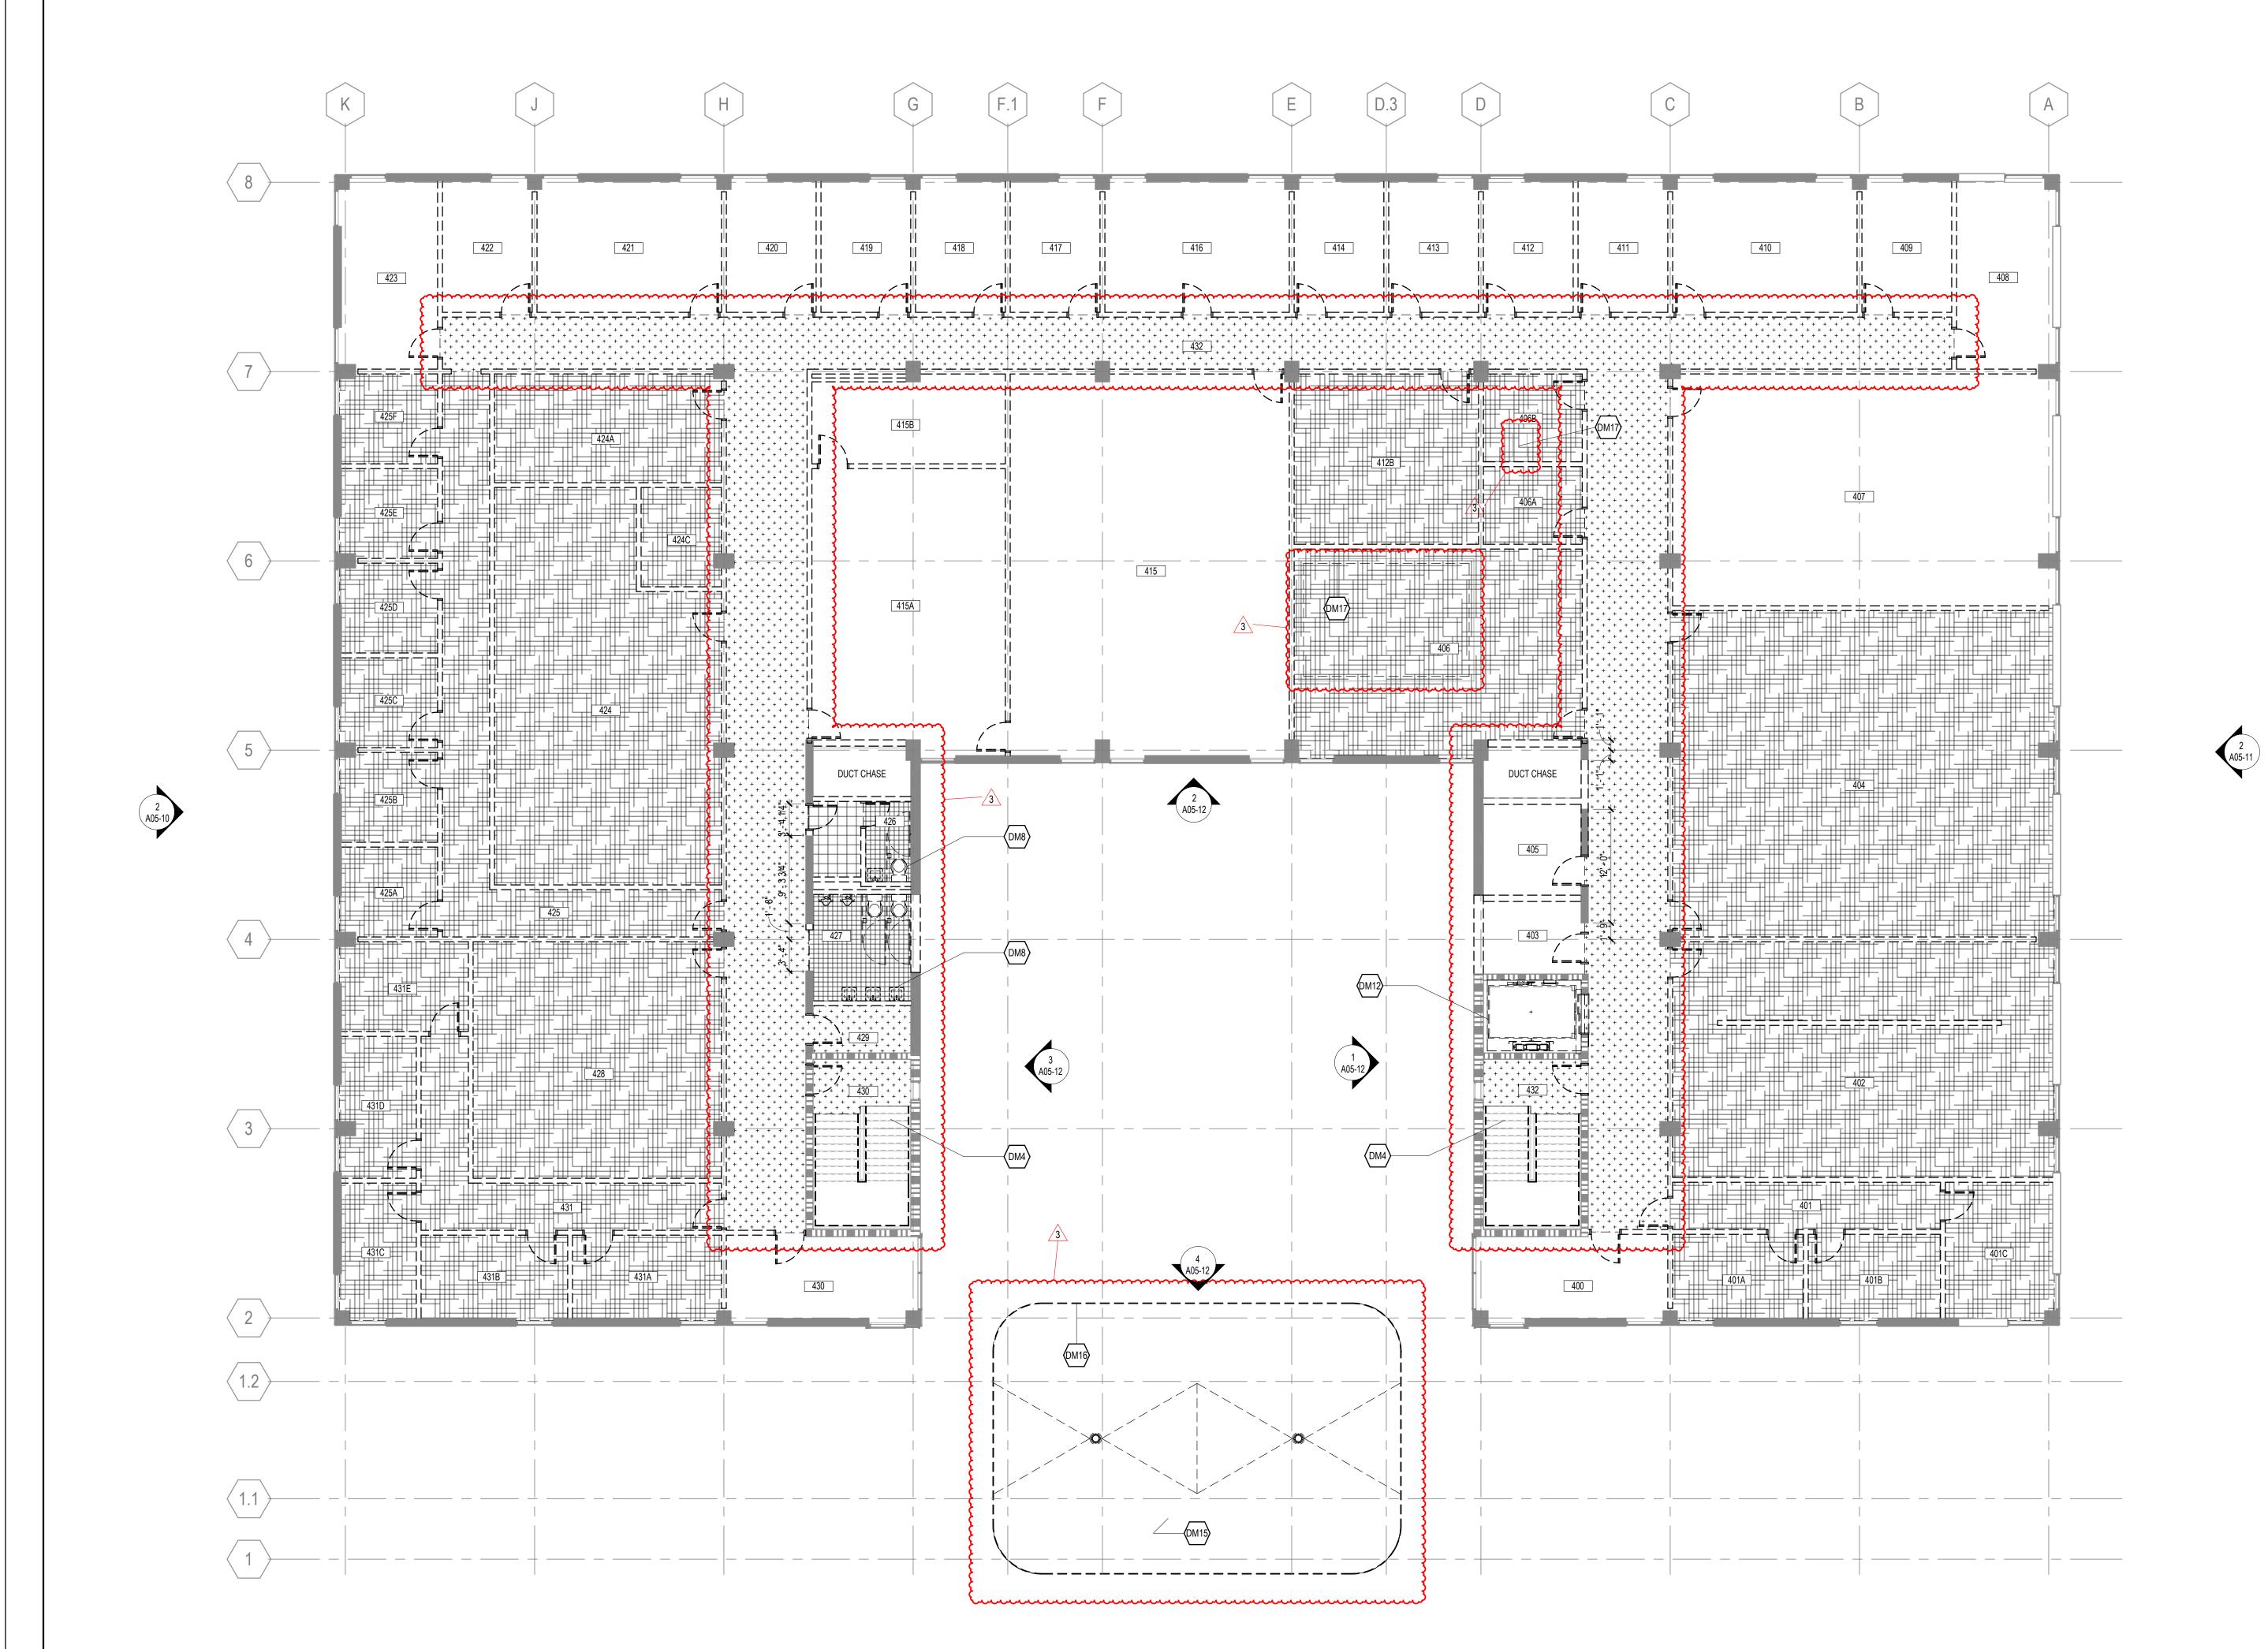

#### **DEMOLITION GENERAL NOTES**

NO SCOPE OUTSIDE OF THE BUILDING ENVELOPE HAS BEEN IDENTIFIED. WHEN SYSTEMS TO BE DEMOLISHED PENETRATE THE EXTERIOR ENVELOPE, TAKE CARE TO NOT DAMAGE ADJACENT SURFACES.

THESE DRAWINGS HAVE BEEN DEVELOPED FROM EXISTING DRAWINGS WHICH MAY NOT REFLECT ACTUAL FIELD CONDITIONS. VERIFY THESE DRAWINGS WITH EXISTING FIELD CONDITIONS AND NOTIFY THE ARCHITECT IMMEDIATELY OF INCONSISTENCIES BETWEEN THEM AND ACTUAL CONDITIONS BEFORE PROCEEDING WITH

REMOVE CONSTRUCTION AS INDICATED. TYPICAL WALL REMOVAL INCLUDES FINISHES AND MECHANICAL PLUMBING AND ELECTRICAL SYSTEMS CONTAINED THEREIN. REMOVE DOORS, CASEWORK, WINDOWS, FRAMES, AND OTHER FIXTURES AS REQUIRED. AFTER REMOVAL OF PIPE CHASES, PATCH HOLES IN FLOORS OR WALLS TO REMAIN TO MEET ORIGINAL FIRE PROTECTION AND STRUCTURAL REQUIREMENTS. PATCH ADJOINING WALLS, FLOORS AND DECK, AND PREPARE SURFACES TO RECEIVE

ASSUME NO SALVAGE / RELOCATION OF MATERIALS UNLESS NOTED OTHERWISE.

SEE MECHANICAL, PLUMBING, AND ELECTRICAL DRAWINGS FOR DEMOLITION OF

DEMOLITION WORK SHALL BE EXECUTED IN CONFORMANCE WITH ALL CODES AND AS SET FORTH BY ALL GOVERNING AUTHORITIES. DO NOT PERFORM ANY STRUCTURAL WORK WITHOUT PRIOR APPROVAL FROM THE

STRUCTURAL ENGINEER. THE BUILDING ENVELOPE SHALL BE MAINTAINED IN A WATER TIGHT CONDITION AT ALL TIMES. TEMPORARY PARTITIONS / PATCHES TO BE UTILIZED AS NEEDED UNTIL FINAL

CONSTRUCTION IS COMPLETED.

9. SCHEDULE ALL DEMOLITION WITH THE OWNER.

10. IN DEMOLITION REFLECTED CEILING PLANS, CONCRETE STRUCTURE TO REMAIN. FLOOR SURFACES THAT ARE NOTED TO BE REMOVED SHOULD BE FULLY DEMOLISHED

FROM UNDERNEATH ALL MILLWORK AND FURNITURE, UNO.

12. CONCRETE FLOOR TO REMAIN IN ALL SPACES, TYPICAL, UNLESS NOTED OTHERWISE.

### Perkins&Will

411 W. Chapel Hill Street Durham, NC 27701 t 919.433.5300 www.perkinswill.com

CONSULTANTS

Lynch Mykins Structural Engineers 301 N. West Street Suite 105, Raleigh, NC 27603

> Salas O'Brien 702 Oberlin Road, Raleigh, NC 27605 License (NC): F-1434

NV5 Engineers and Consultants

3300 Regency Parkway Suite 100, Cary, NC 27518

Holder Construction Group 6210 Ardrey Kell Road Suite 400, Charlotte, NC 28277

NV5 Engineers and Consultants

4905 Professional Court, Raleigh, NC 27609

Available Light 5700 Six Forks Road, Suite 203, Raleigh, NC 27609

SUSTAINABILITY **Ecoimpact Consulting** 8022 Providence Road Suite 500, Charlotte, NC 28277

#### **DEMOLITION LEGEND**

EXISTING CONSTRUCTION TO REMAIN

EXISTING 2-HR RATED CONSTRUCTION TO REMAIN

CONSTRUCTION TO BE REMOVED

EPOXY FLOOR TO BE REMOVED COMPLETELY TO SUBSTRATE.

LINOLEUM FLOOR TILES TO BE REMOVED TO SUBSTRATE.

CERAMIC FLOOR TILES TO BE REMOVED TO SUBSTRATE.

TERRAZZO FLOOR TO BE REMOVED TO MATCH ADJACENT SLAB **ELEVATION** 

CARPET TO BE REMOVED TO SUBSTRATE.

### **DEMOLITION NOTES BY NUMBER**

| <<< Indicates Sheet Keynote on Plan</p>


DM4 HANDRAIL, GUARDRAIL, AND STAIR TREADS, EXISTING TO REMAIN.

DM8 REMOVE ALL PLUMBING FIXTURES, SEE PLUMBING DRAWINGS. DM12 ALTERNATE 1: REMOVE ELEVATOR CAB, COUNTERWEIGHTS, RAILS, DOOR DM15 REMOVE EXTENT OF EXISTING ROOF INSULATION AND SUBSTRATE.

DM16 REMOVE EXISTING COPING.

DM17 REMOVE PORTION OF SLAB, SEE STRUCTURAL 



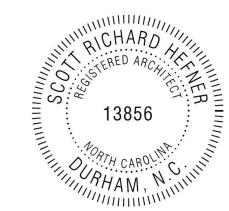

Mann Hall Renovation STATE ID #22-24500-02B NCSU PROJECT # 202220021

**North Carolina State** University Facilities Division Design & Construction Administrative Services Building III 2601 Wolf Village Way, Suite 331 Raleigh, NC 27695



**ISSUE CHART** 


| 3            | ISSUE FOR BID - PROC       | 01/17/2025 |
|--------------|----------------------------|------------|
| 2            | ISSUE FOR BID - DEMO REV 1 | 10/28/2024 |
| 1            | ISSUE FOR BID - DEMO       | 4/17/2024  |
| MARK         | ISSUE                      | DATE       |
| Job N        | umber 83                   | 20937.001  |
| Drawr        | 1                          | Author     |
| Check        | ed                         | Checker    |
| Annroyed Ann |                            |            |

**DEMOLITION PLAN -**FLOOR 04

SHEET NUMBER

A04-04

1/8" = 1'-0"

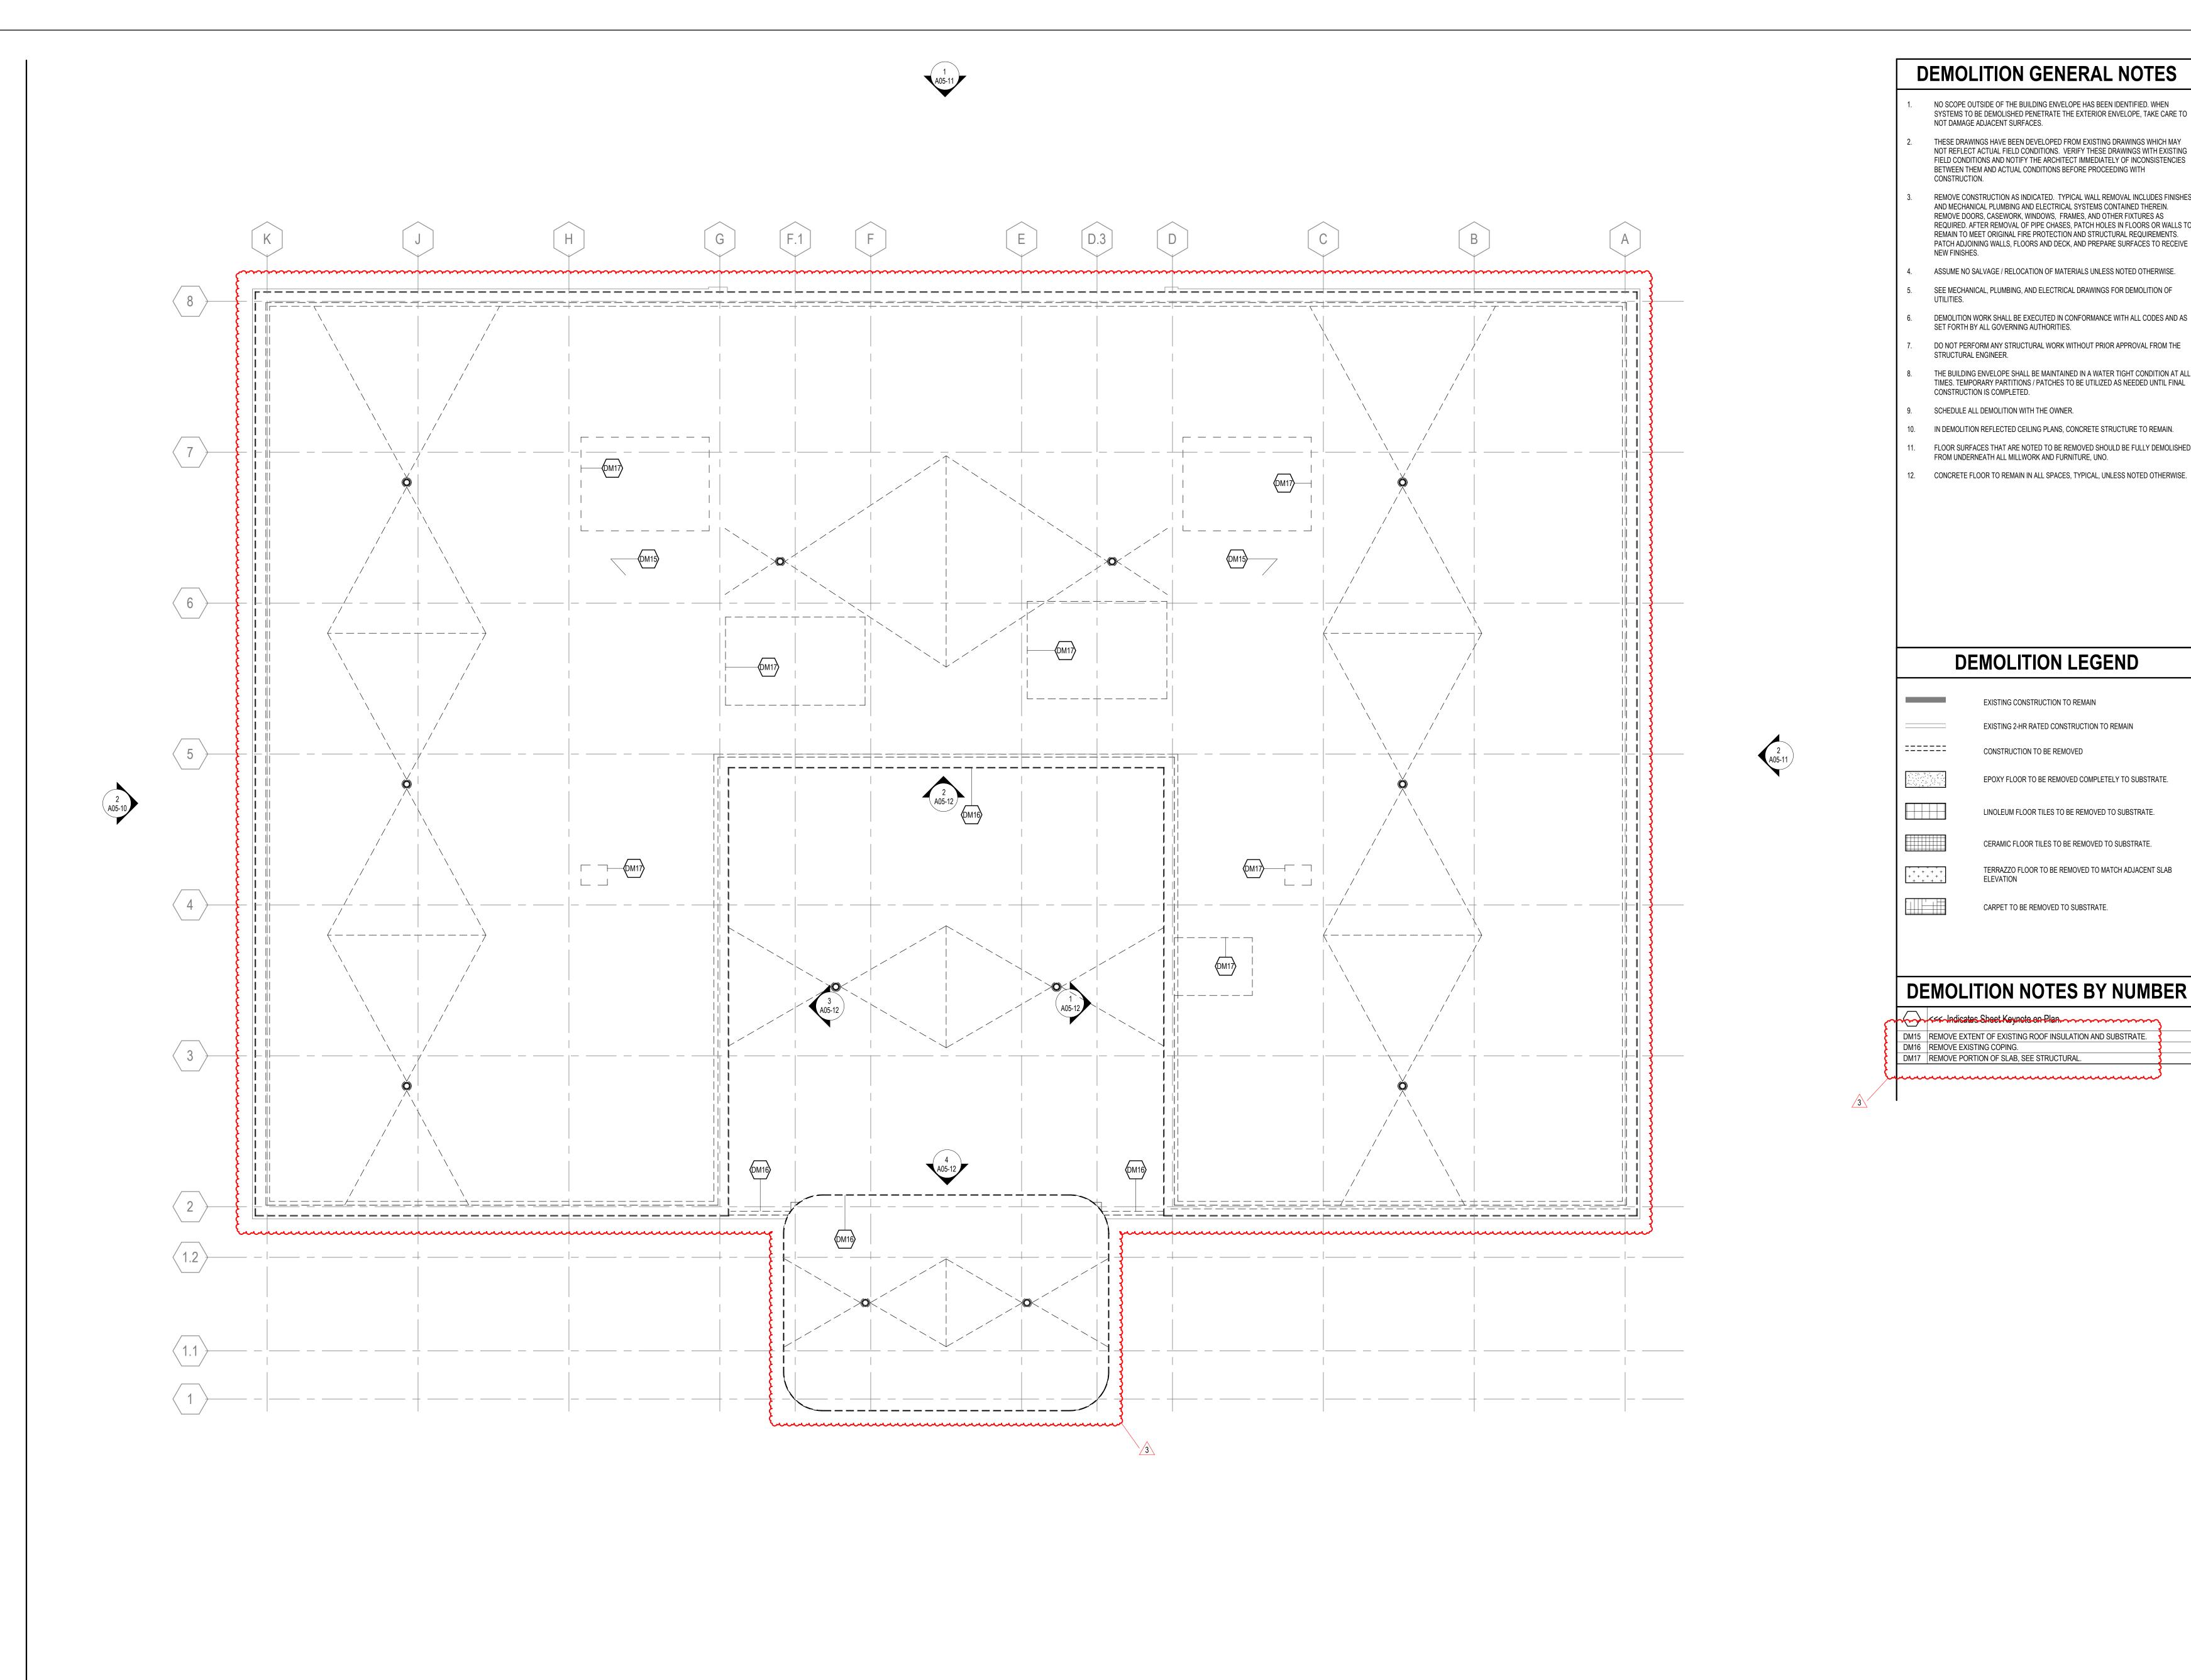

1/8" = 1'-0"

#### **DEMOLITION GENERAL NOTES**

NO SCOPE OUTSIDE OF THE BUILDING ENVELOPE HAS BEEN IDENTIFIED. WHEN SYSTEMS TO BE DEMOLISHED PENETRATE THE EXTERIOR ENVELOPE, TAKE CARE TO NOT DAMAGE ADJACENT SURFACES.

- THESE DRAWINGS HAVE BEEN DEVELOPED FROM EXISTING DRAWINGS WHICH MAY NOT REFLECT ACTUAL FIELD CONDITIONS. VERIFY THESE DRAWINGS WITH EXISTING FIELD CONDITIONS AND NOTIFY THE ARCHITECT IMMEDIATELY OF INCONSISTENCIES BETWEEN THEM AND ACTUAL CONDITIONS BEFORE PROCEEDING WITH
- REMOVE CONSTRUCTION AS INDICATED. TYPICAL WALL REMOVAL INCLUDES FINISHES AND MECHANICAL PLUMBING AND ELECTRICAL SYSTEMS CONTAINED THEREIN. REMOVE DOORS, CASEWORK, WINDOWS, FRAMES, AND OTHER FIXTURES AS REQUIRED. AFTER REMOVAL OF PIPE CHASES, PATCH HOLES IN FLOORS OR WALLS TO REMAIN TO MEET ORIGINAL FIRE PROTECTION AND STRUCTURAL REQUIREMENTS. PATCH ADJOINING WALLS, FLOORS AND DECK, AND PREPARE SURFACES TO RECEIVE
- ASSUME NO SALVAGE / RELOCATION OF MATERIALS UNLESS NOTED OTHERWISE.
- SEE MECHANICAL, PLUMBING, AND ELECTRICAL DRAWINGS FOR DEMOLITION OF
- SET FORTH BY ALL GOVERNING AUTHORITIES. DO NOT PERFORM ANY STRUCTURAL WORK WITHOUT PRIOR APPROVAL FROM THE
- STRUCTURAL ENGINEER.
- THE BUILDING ENVELOPE SHALL BE MAINTAINED IN A WATER TIGHT CONDITION AT ALL TIMES. TEMPORARY PARTITIONS / PATCHES TO BE UTILIZED AS NEEDED UNTIL FINAL CONSTRUCTION IS COMPLETED.
- 9. SCHEDULE ALL DEMOLITION WITH THE OWNER.
- 10. IN DEMOLITION REFLECTED CEILING PLANS, CONCRETE STRUCTURE TO REMAIN.
- FLOOR SURFACES THAT ARE NOTED TO BE REMOVED SHOULD BE FULLY DEMOLISHED FROM UNDERNEATH ALL MILLWORK AND FURNITURE, UNO.
- 12. CONCRETE FLOOR TO REMAIN IN ALL SPACES, TYPICAL, UNLESS NOTED OTHERWISE.

## Perkins&Will

411 W. Chapel Hill Street Durham, NC 27701 t 919.433.5300 www.perkinswill.com

CONSULTANTS

STRUCTURAL Lynch Mykins Structural Engineers 301 N. West Street Suite 105, Raleigh, NC 27603

> Salas O'Brien 702 Oberlin Road, Raleigh, NC 27605 License (NC): F-1434

NV5 Engineers and Consultants 3300 Regency Parkway Suite 100, Cary, NC 27518

Holder Construction Group 6210 Ardrey Kell Road Suite 400, Charlotte, NC 28277

NV5 Engineers and Consultants

4905 Professional Court, Raleigh, NC 27609

Available Light

5700 Six Forks Road, Suite 203, Raleigh, NC 27609 SUSTAINABILITY

**Ecoimpact Consulting** 8022 Providence Road Suite 500, Charlotte, NC 28277

#### **DEMOLITION LEGEND**

EXISTING CONSTRUCTION TO REMAIN

EXISTING 2-HR RATED CONSTRUCTION TO REMAIN

CONSTRUCTION TO BE REMOVED

EPOXY FLOOR TO BE REMOVED COMPLETELY TO SUBSTRATE.

LINOLEUM FLOOR TILES TO BE REMOVED TO SUBSTRATE.

CERAMIC FLOOR TILES TO BE REMOVED TO SUBSTRATE.

TERRAZZO FLOOR TO BE REMOVED TO MATCH ADJACENT SLAB

#### DEMOLITION NOTES BY NUMBER

DM15 REMOVE EXTENT OF EXISTING ROOF INSULATION AND SUBSTRATE.
DM16 REMOVE EXISTING COPING.

DM17 REMOVE PORTION OF SLAB, SEE STRUCTURAL.



Mann Hall Renovation STATE ID #22-24500-02B NCSU PROJECT # 202220021



**North Carolina State** University Facilities Division Design & Construction Administrative Services Building III 2601 Wolf Village Way, Suite 331 Raleigh, NC 27695



**ISSUE CHART** 

| Check |                          | Checker      |
|-------|--------------------------|--------------|
| Drawr | 1                        | Author       |
| Job N | umber                    | 820937.001   |
| MARK  | ISSUE                    | DATE         |
| 1     | ISSUE FOR BID - DEMO     | 4/17/2024    |
| 2     | ISSUE FOR BID - DEMO REV | 1 10/28/2024 |
| 3     | ISSUE FOR BID - PROC     | 01/17/2025   |

**DEMOLITION PLAN -**

SHEET NUMBER

A04-05



Legacy Tower
411 W Chapel Hill Street, Suite 200
Durham, North Carolina 27701
t 919.433.5300

t 919.433.5300 f 919.433.5301 www.perkinswill.com

STRUCTURAL

Lynch Mykins Structural Engineers

301 N. West Street Suite 105, Raleigh, NC 27603

Salas O'Brien
702 Oberlin Road, Raleigh, NC 27605
License (NC): F-1434
CIVIL
NV5 Engineers and Consultants

3300 Regency Parkway Suite 100, Cary, NC 27518

CONTRACTOR

Holder Construction Group
6210 Ardrey Kell Road Suite 400, Charlotte, NC 28277

AUDIO/VISUAL

NV5 Engineers and Consultants
4905 Professional Court, Raleigh, NC 27609

LIGHTING

Available Light

5700 Six Forks Road, Suite 203, Raleigh, NC 27609

SUSTAINABILITY

Ecoimpact Consulting

8022 Providence Road Suite 500, Charlotte, NC 28277

Mann Hall Renovation

STATE ID #22-24500-02B

NCSU PROJECT # 202220021



North Carolina State
University

Facilities Division Design & Construction
Administrative Services Building III
2601 Wolf Village Way, Suite 331
Raleigh, NC 27695

RUE DRTH ISSUE CHART

| 3 | ISSUE FOR BID - PROC | 01/17/2025 |
| 2 | ISSUE FOR BID - DEMO REV 1 | 10/28/2024 |
| 1 | ISSUE FOR BID - DEMO | 4/17/2024 |
| MARK | ISSUE | DATE |
| Job Number | 820937.001 |
| Drawn | Author |
| Checked | Checker |
| Approved | TITLE |

DEMOLITION EXTERIOR ELEVATIONS

SHEET NUMBER

A05-10



**EXTERIOR ELEVATION GENERAL NOTES** 

MATERIAL SYMBOLS ON ELEVATIONS ARE TO DISPLAY THE EXTENT OF THE

**EXTERIOR ELEVATION LEGEND** 

A EXTERIOR GLAZING SYSTEM TAG REFER TO A33 SERIES FOR **BUILDING EXPANSION JOINT** 

FLOOR 03 420' - 5 1/2"

FLOOR 02

FLOOR 01 394' - 8"

Perkins&Will

Legacy Tower 411 W Chapel Hill Street, Suite 200 Durham, North Carolina 27701 t 919.433.5300 f 919.433.5301 www.perkinswill.com

CONSULTANTS STRUCTURAL Lynch Mykins Structural Engineers 301 N. West Street Suite 105, Raleigh, NC 27603

> Salas O'Brien 702 Oberlin Road, Raleigh, NC 27605 License (NC): F-1434

NV5 Engineers and Consultants

3300 Regency Parkway Suite 100, Cary, NC 27518 Holder Construction Group 6210 Ardrey Kell Road Suite 400, Charlotte, NC 28277

> AUDIO/VISUAL NV5 Engineers and Consultants 4905 Professional Court, Raleigh, NC 27609 Available Light

5700 Six Forks Road, Suite 203, Raleigh, NC 27609 SUSTAINABILITY **Ecoimpact Consulting** 8022 Providence Road Suite 500, Charlotte, NC 28277

> Mann Hall Renovation STATE ID #22-24500-02B NCSU PROJECT # 202220021



**North Carolina State** University Facilities Division Design & Construction Administrative Services Building III 2601 Wolf Village Way, Suite 331 Raleigh, NC 27695

**ISSUE CHART** 

ISSUE FOR BID - PROC 01/17/2025 ISSUE FOR BID - DEMO REV 1 10/28/2024 ISSUE FOR BID - DEMO 4/17/2024 820937.001 Job Number Approver TITLE


> **DEMOLITION EXTERIOR ELEVATIONS**

> > SHEET NUMBER

A05-11

NORTH ELEVATION Copy 1

1/8" = 1'-0"

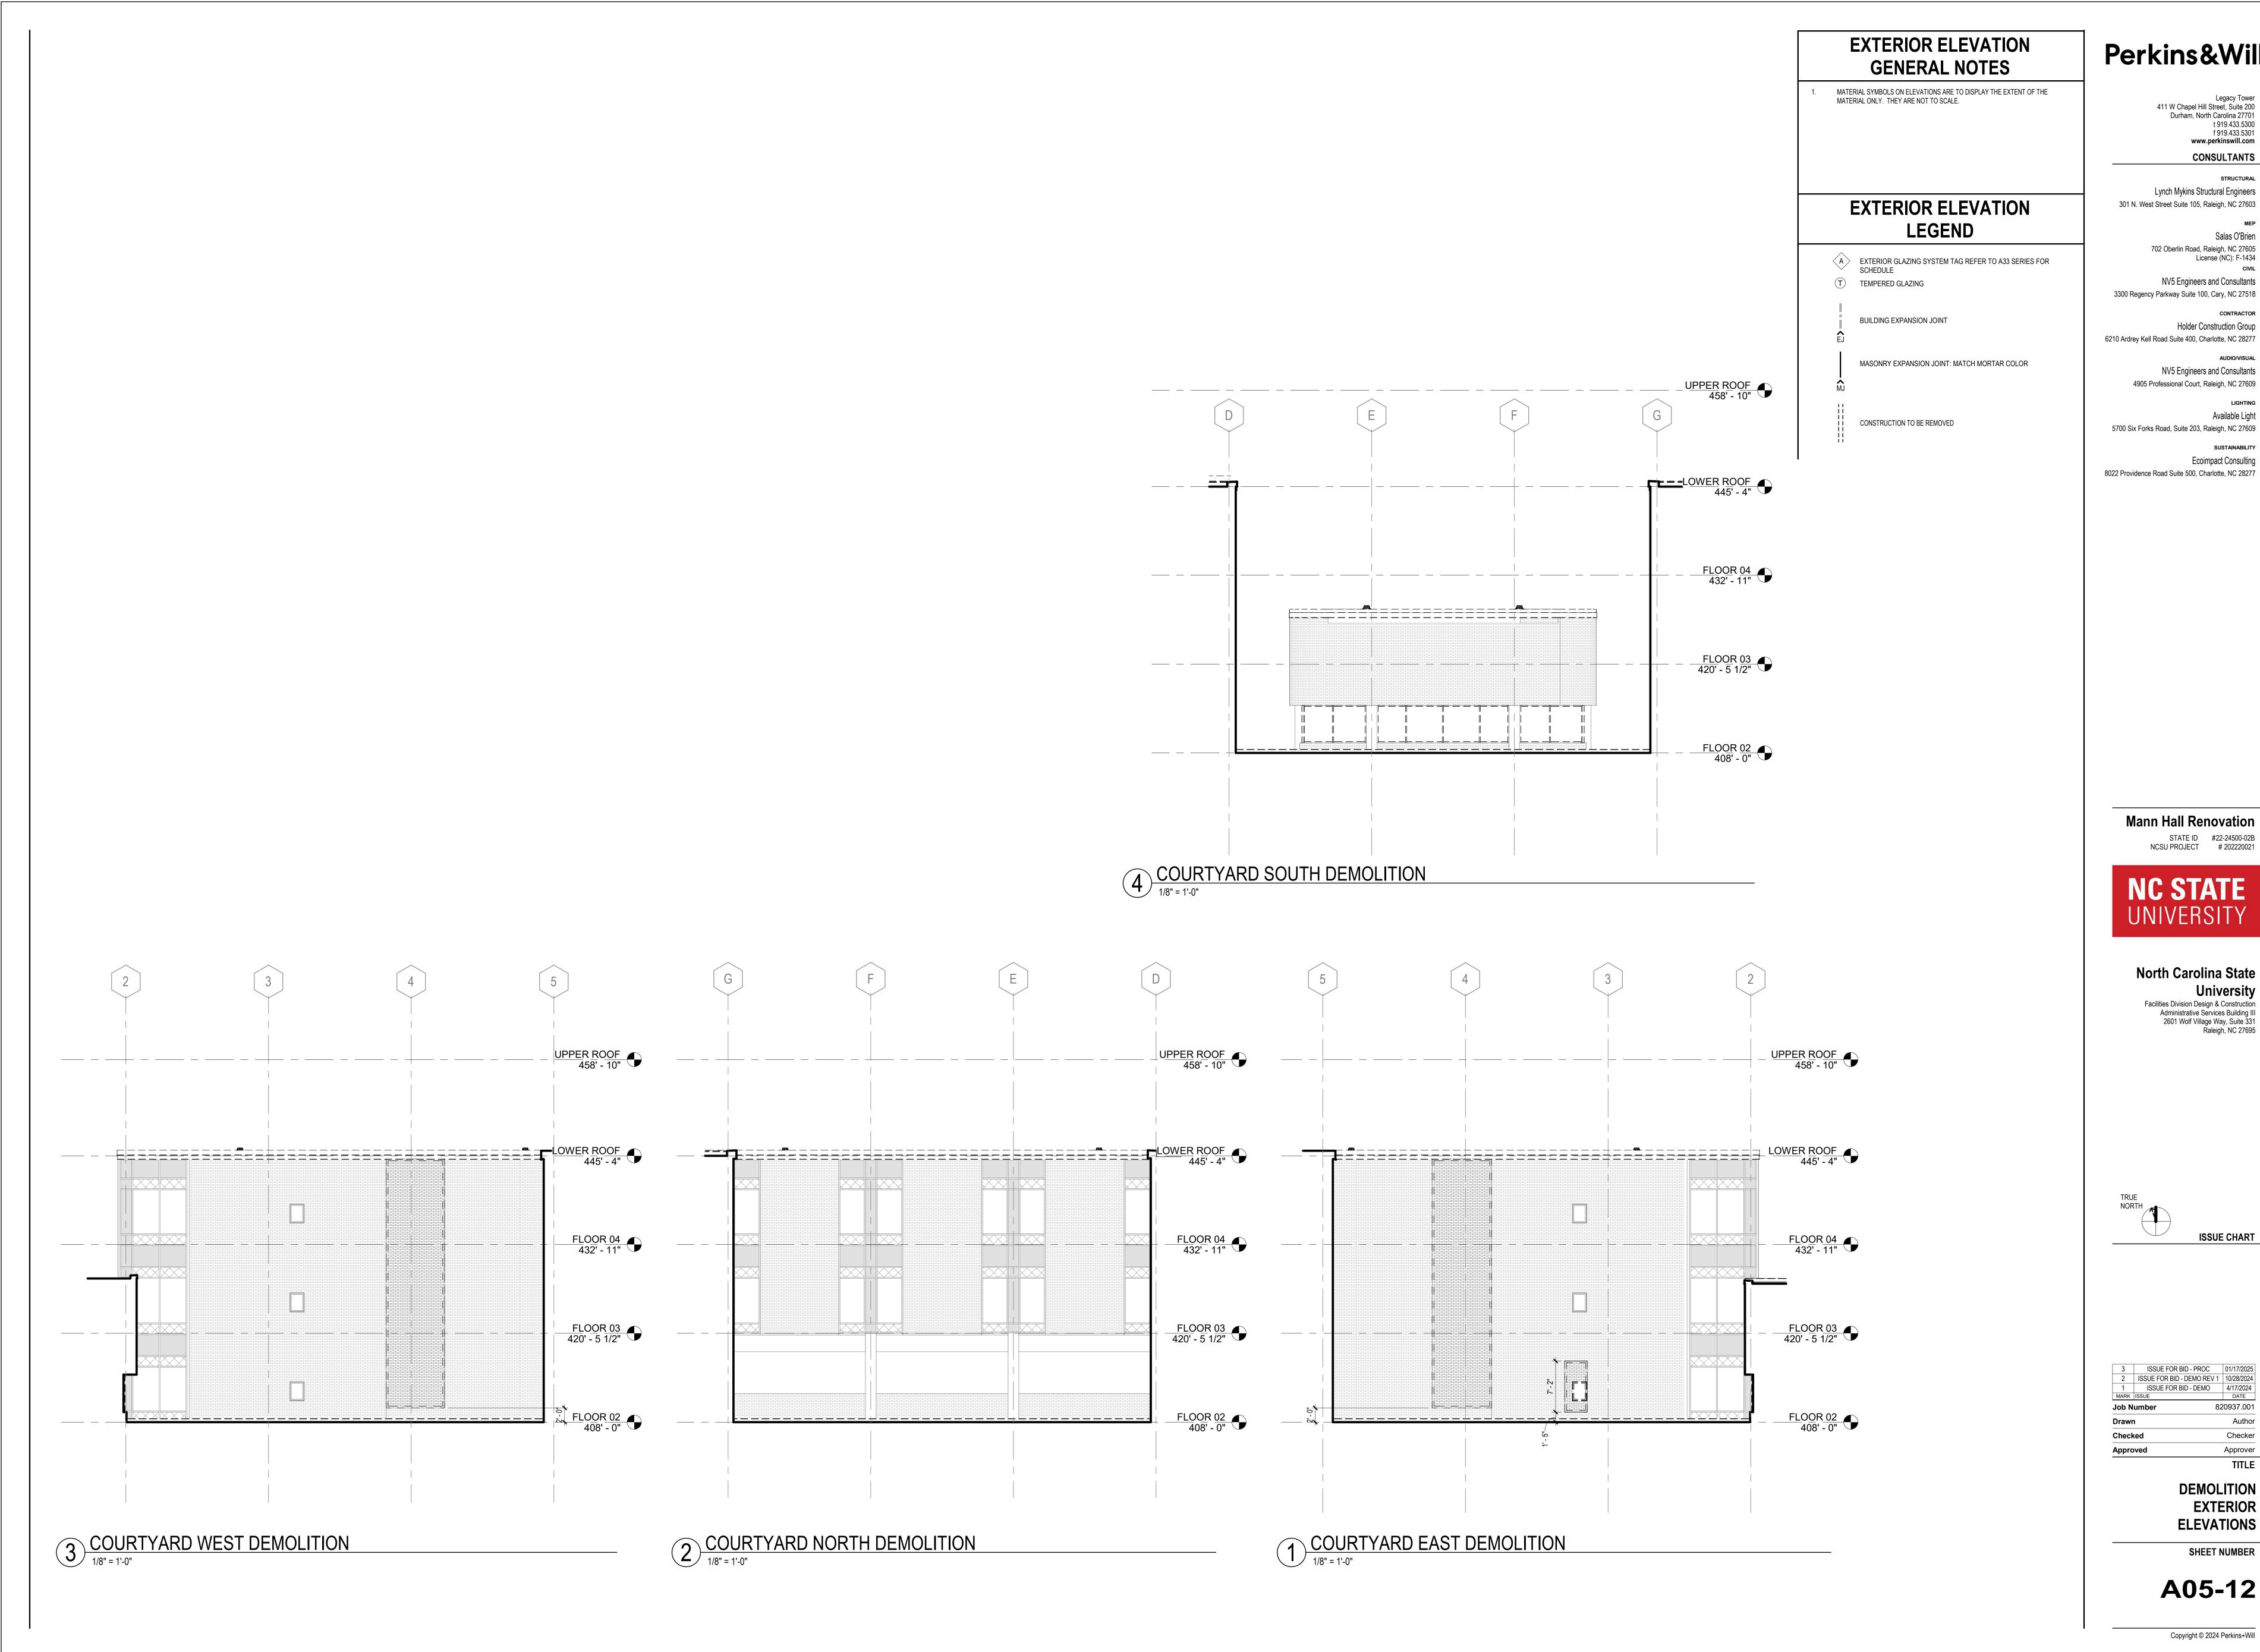

Legacy Tower 411 W Chapel Hill Street, Suite 200 Durham, North Carolina 27701 t 919.433.5300

f 919.433.5301 www.perkinswill.com

STRUCTURAL Lynch Mykins Structural Engineers 301 N. West Street Suite 105, Raleigh, NC 27603

> Salas O'Brien 702 Oberlin Road, Raleigh, NC 27605 License (NC): F-1434

NV5 Engineers and Consultants 3300 Regency Parkway Suite 100, Cary, NC 27518

Holder Construction Group 6210 Ardrey Kell Road Suite 400, Charlotte, NC 28277

> AUDIO/VISUAL NV5 Engineers and Consultants 4905 Professional Court, Raleigh, NC 27609

Available Light 5700 Six Forks Road, Suite 203, Raleigh, NC 27609

SUSTAINABILITY **Ecoimpact Consulting** 8022 Providence Road Suite 500, Charlotte, NC 28277

Mann Hall Renovation




**North Carolina State** University Facilities Division Design & Construction Administrative Services Building III 2601 Wolf Village Way, Suite 331 Raleigh, NC 27695

**ISSUE CHART** 

ISSUE FOR BID - PROC 01/17/2025 ISSUE FOR BID - DEMO REV 1 10/28/2024 1 ISSUE FOR BID - DEMO 4/17/2024 820937.001

> Approver TITLE **DEMOLITION EXTERIOR**

A05-12

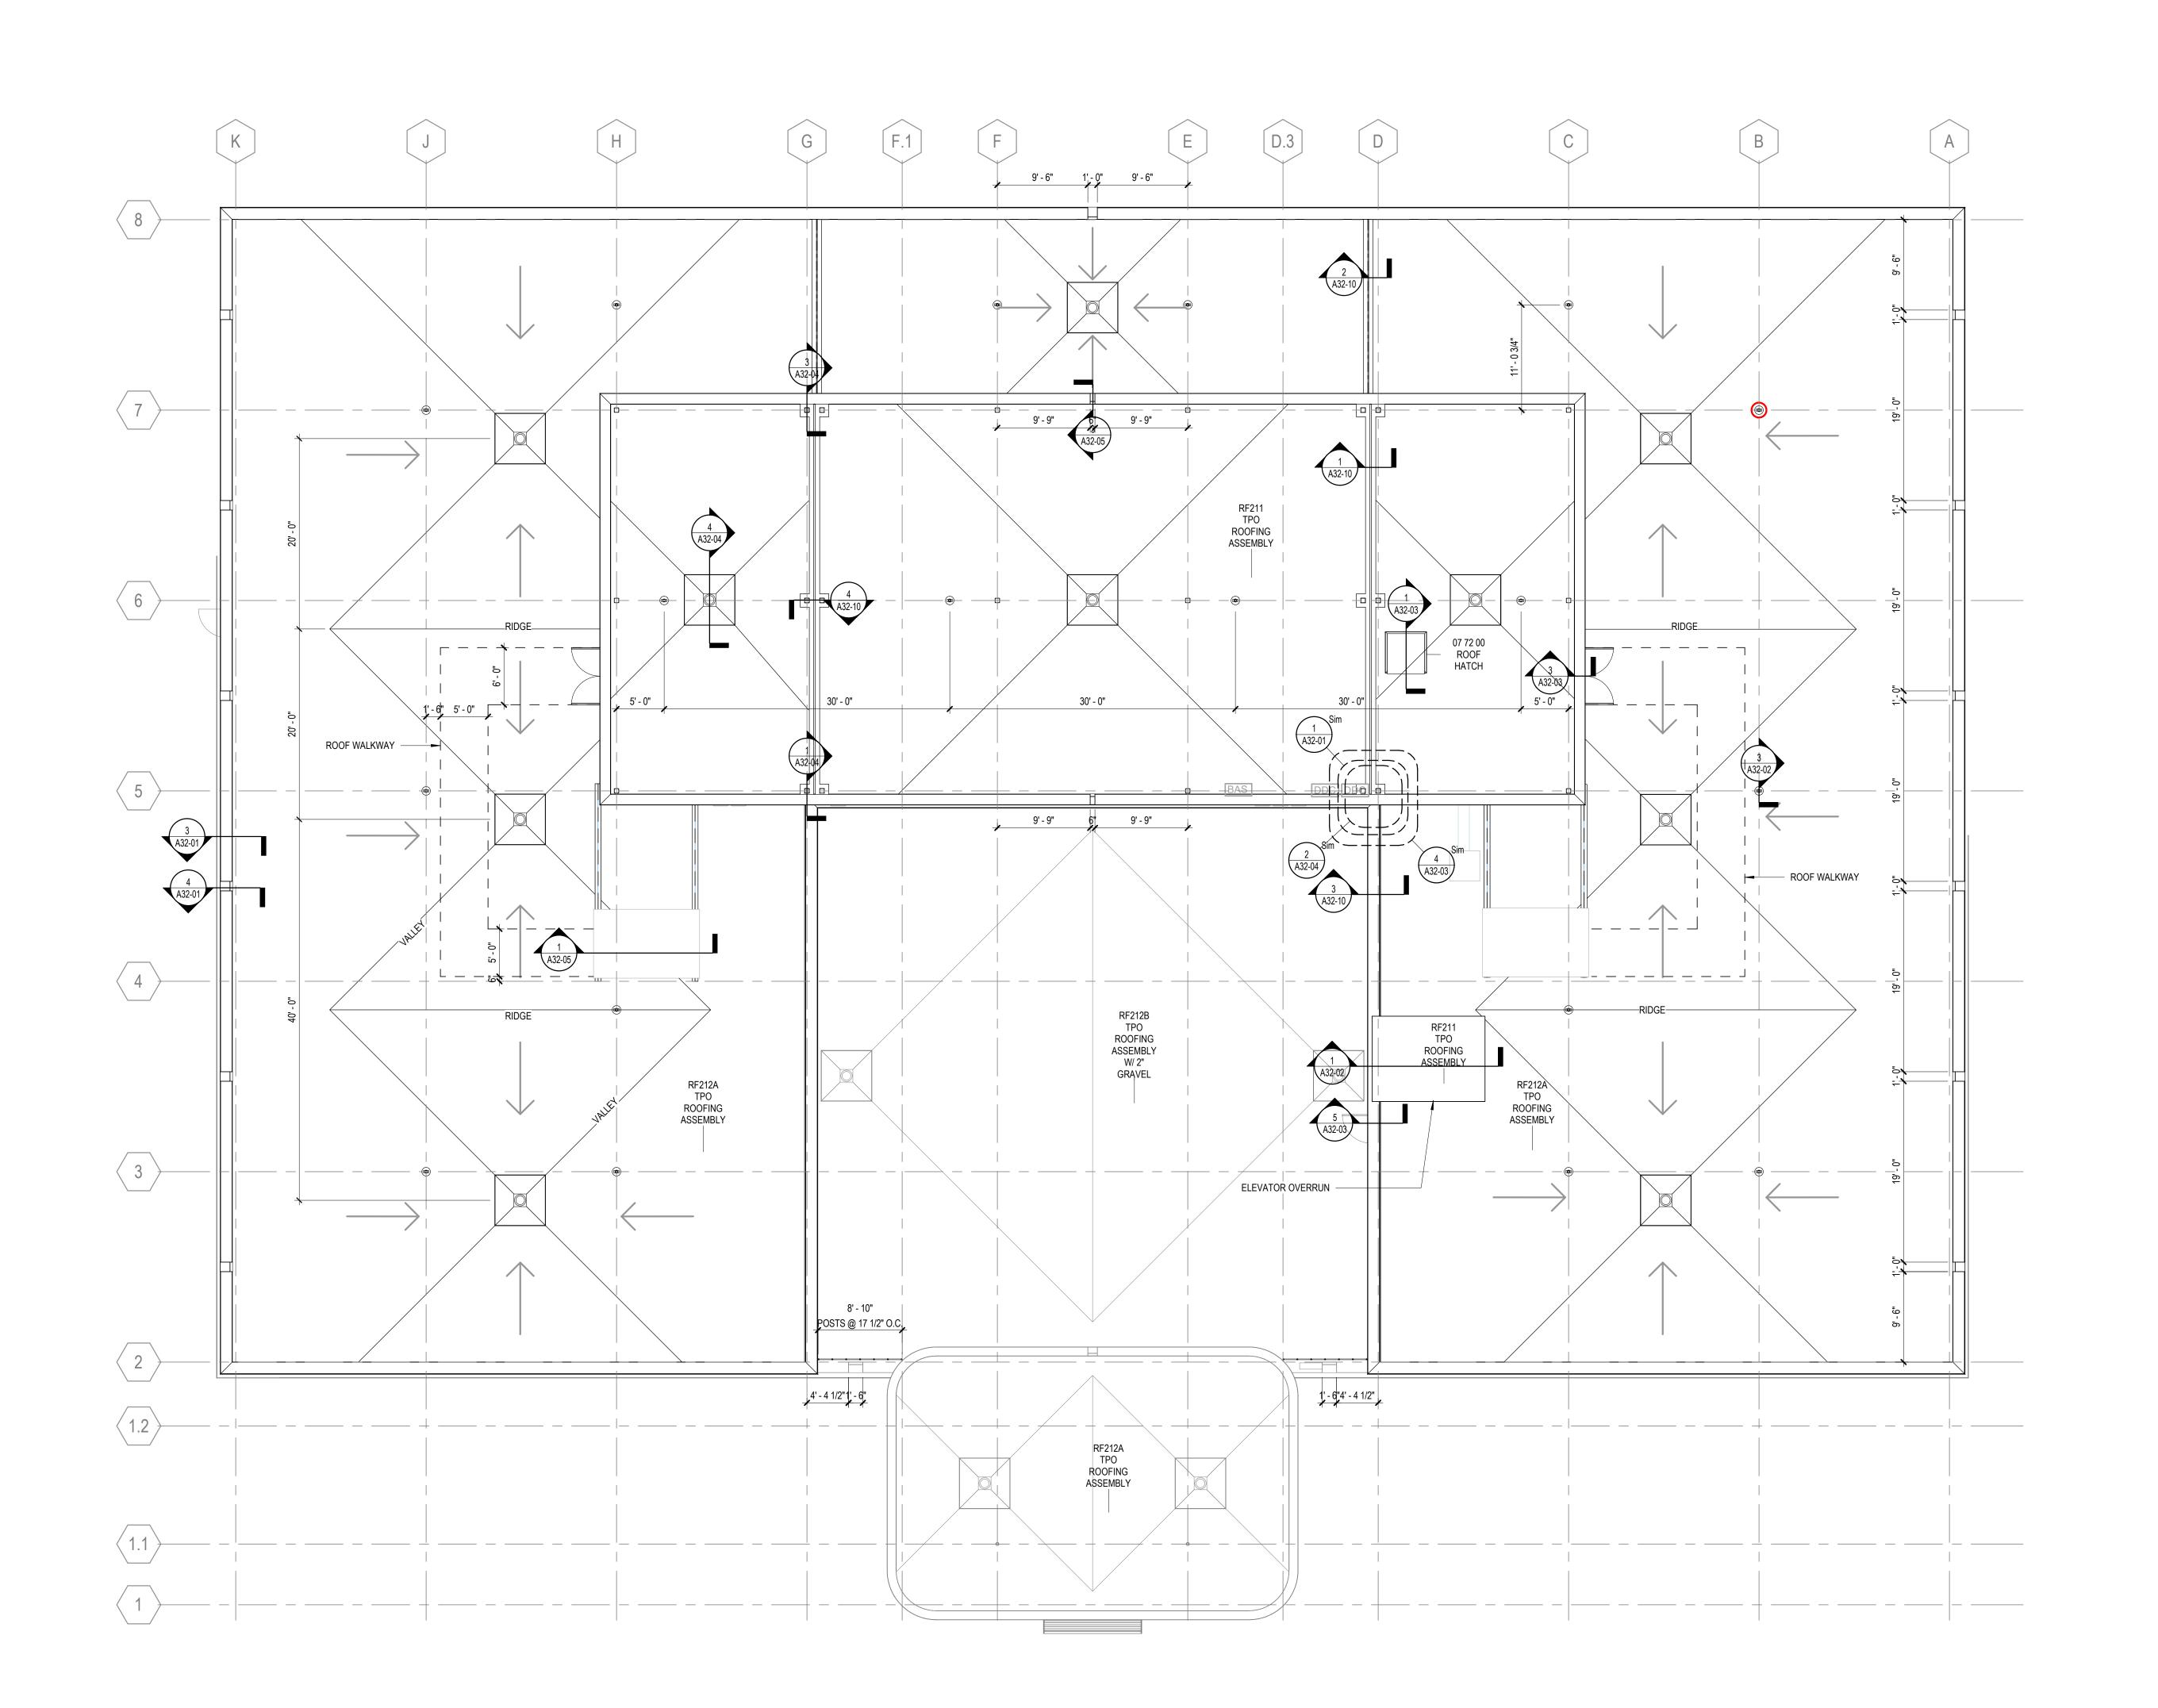

## ROOF PLAN GENERAL NOTES

REFER TO STRUCTURAL, MECHANICAL, PLUMBING, AND ELECTRICAL FOR LOCATIONS OF OTHER ITEMS ON THE ROOF SURFACE.

PAINT EXPOSED ROOF MOUNTED EQUIPMENT, PIPING, ETC., EXCEPT THOSE ITEMS WHICH ARE PREFINISHED OR STAINLESS STEEL. COLOR AS SELECTED BY ARCHITECT.

**ROOF PLAN LEGEND** 

SCUPPER

DOWN SPOUT

ROOF WALK PADS.

**ROOF DRAIN SUMP** 

RIDGE HIGH POINT AT TOP OF INSULATION

VALLEY LOW POINT AT TOP OF INSULATION

AREA WITH SLOPED STRUCTURE

T/PARAPET TOP OF PARAPET

SLOPE TO DRAIN 1/4" PER FOOT

SLOPE TO DRAIN 1/2" PER FOOT

AREA WITH TAPERED INSULATION

**ROOF PLAN** 

**NOTES BY NUMBER** 

REFER TO PLUMBING DRAWINGS FOR ROOF DRAIN SIZES.

301 N. West Street Suite 105, Raleigh, NC 27603

MEP

Salas O'Brien

702 Oberlin Road, Raleigh, NC 27605

Perkins&Will

Legacy Tower 411 W Chapel Hill Street, Suite 200 Durham, North Carolina 27701

Lynch Mykins Structural Engineers

t 919.433.5300

f 919.433.5301 www.perkinswill.com

STRUCTURAL

**CONSULTANTS** 

License (NC): F-1434
cıvıL

NV5 Engineers and Consultants
3300 Regency Parkway Suite 100, Cary, NC 27518

CONTRACTOR
Holder Construction Group
6210 Ardrey Kell Road Suite 400, Charlotte, NC 28277

NV5 Engineers and Consultants
4905 Professional Court, Raleigh, NC 27609

LIGHTING
Available Light
5700 Six Forks Road, Suite 203, Raleigh, NC 27609
SUSTAINABILITY

Ecoimpact Consulting 8022 Providence Road Suite 500, Charlotte, NC 28277

Mann Hall Renovation

STATE ID #22-24500-02B


NCSU PROJECT # 202220021



North Carolina State
University

Facilities Division Design & Construction
Administrative Services Building III
2601 Wolf Village Way, Suite 331
Raleigh, NC 27695



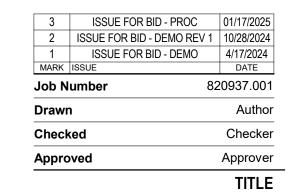

FLOOR PLAN - ROOF


SHEET NUMBER

A11-06

Copyright © 2024 Perkins+Will

FLOOR PLAN - ROOF

1/8" = 1'-0"

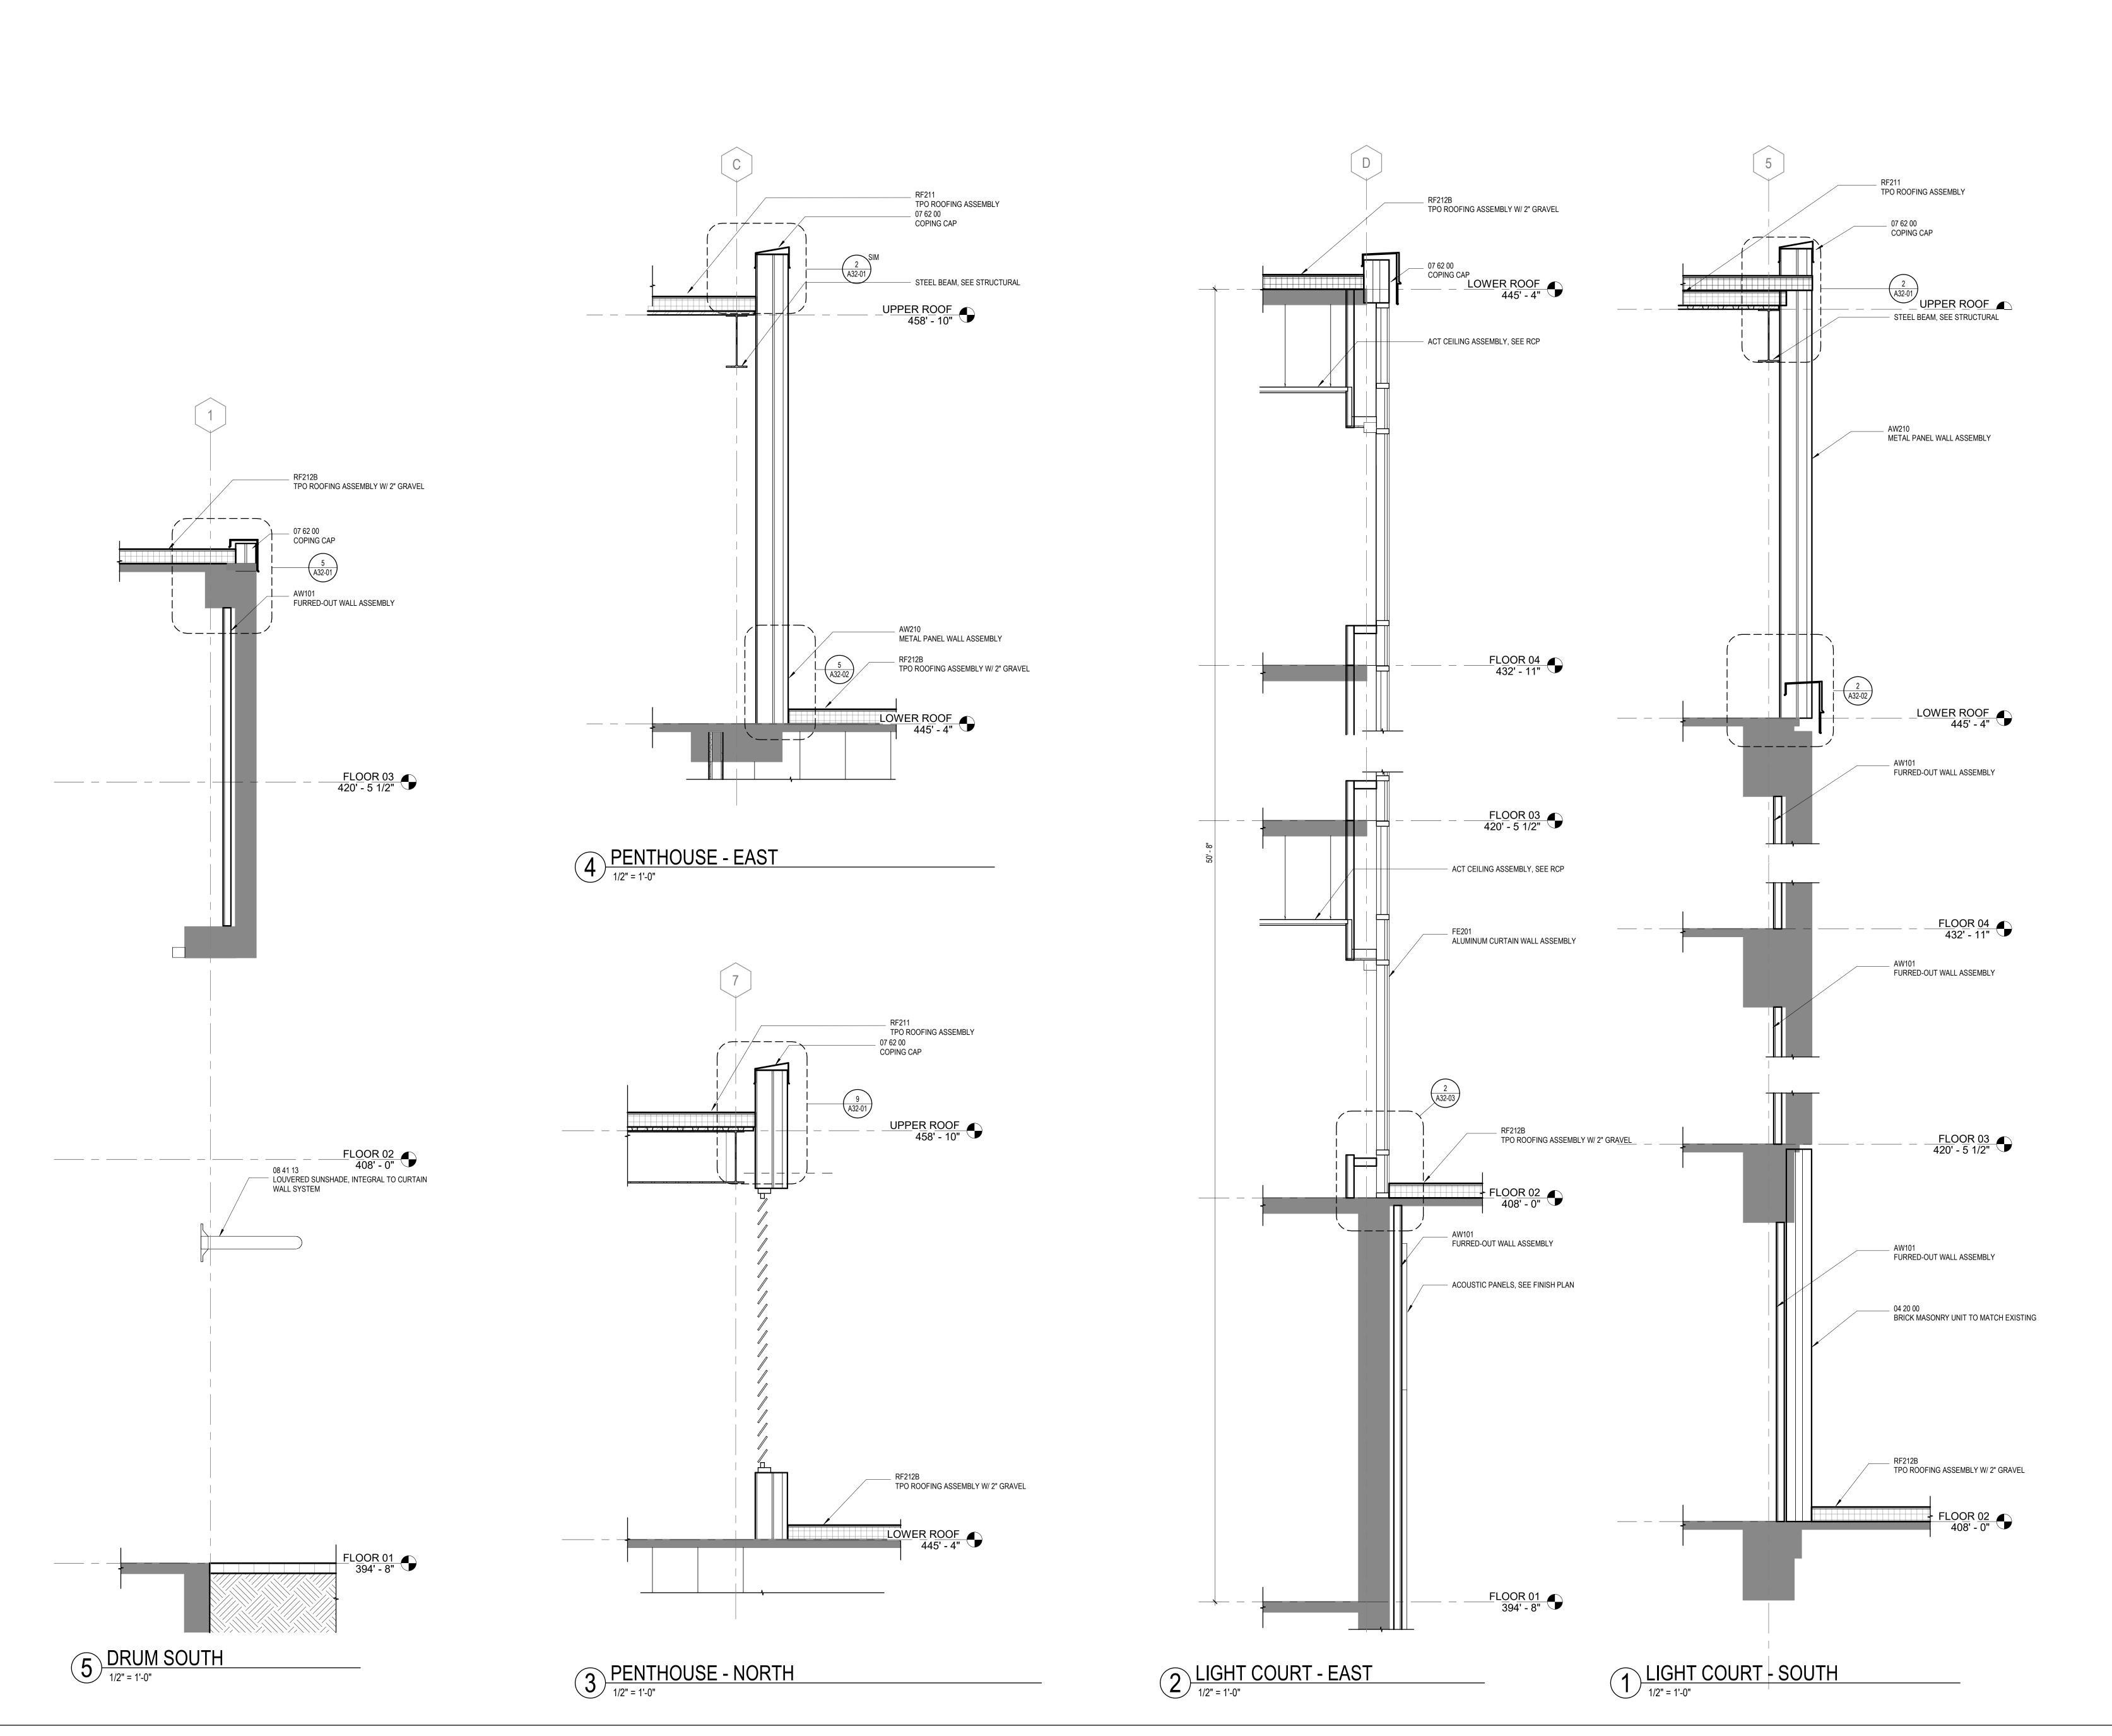

Legacy Tower
411 W Chapel Hill Street, Suite 200
Durham, North Carolina 27701
t 919.433.5300
f 919.433.5301
www.perkinswill.com

CONSULTANTS

STRUCTURAL

Lynch Mykins Structural Engineers

301 N. West Street Suite 105, Raleigh, NC 27603

Salas O'Brien 702 Oberlin Road, Raleigh, NC 27605 License (NC): F-1434

NV5 Engineers and Consultants
3300 Regency Parkway Suite 100, Cary, NC 27518

CONTRACTOR
Holder Construction Group
6210 Ardrey Kell Road Suite 400, Charlotte, NC 28277

AUDIO/VISUAL NV5 Engineers and Consultants 4905 Professional Court, Raleigh, NC 27609

LIGHTING

Available Light
5700 Six Forks Road, Suite 203, Raleigh, NC 27609

sustainability

Ecoimpact Consulting

8022 Providence Road Suite 500, Charlotte, NC 28277

Mann Hall Renovation

STATE ID #22-24500-02B

NCSU PROJECT # 202220021



North Carolina State
University
Facilities Division Design & Construction
Administrative Services Building III
2601 Wolf Village Way, Suite 331
Raleigh, NC 27695


ISSUE CHART

| 3 | ISSUE FOR BID - PROC | 01/17/2025 |
| 2 | ISSUE FOR BID - DEMO REV 1 | 10/28/2024 |
| 1 | ISSUE FOR BID - DEMO | 4/17/2024 |
| MARK | ISSUE | DATE |
| Job Number | 820937.001 |
| Drawn | Author |
| Checked | Checker |
| Approved | TITLE |

WALL SECTIONS

SHEET NUMBER

A31-01

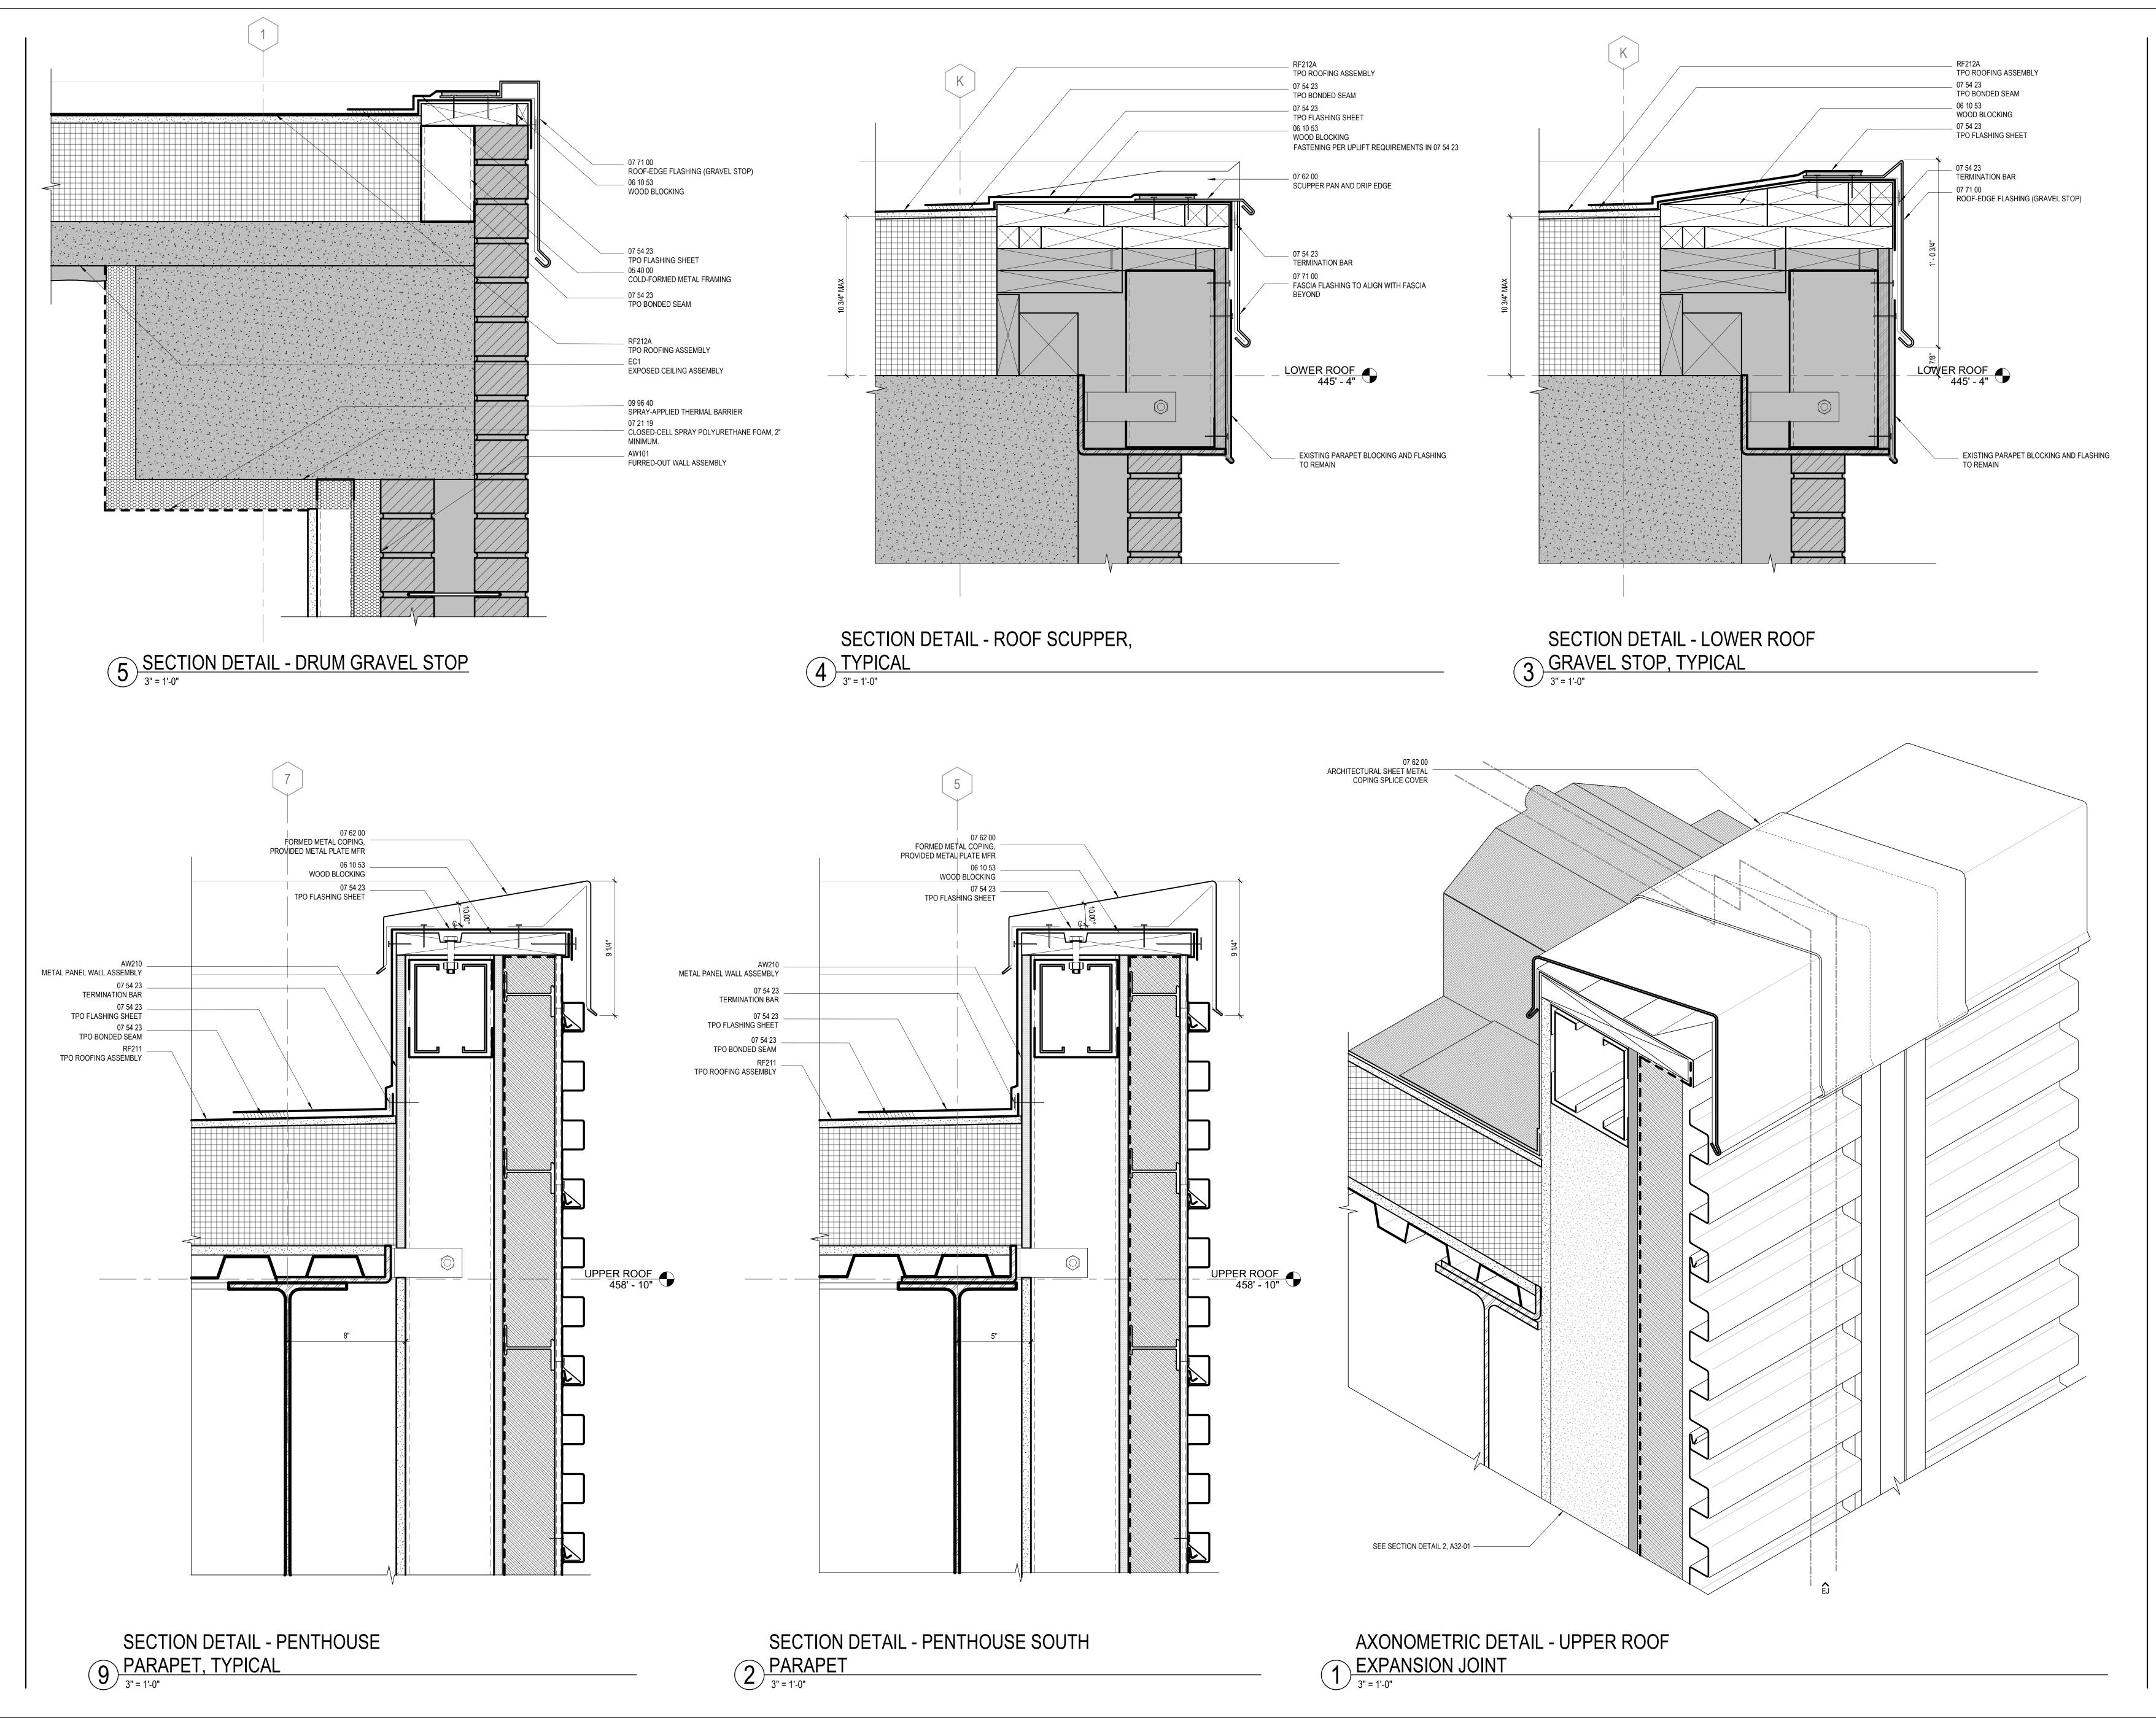

Legacy Tower 411 W Chapel Hill Street, Suite 200 Durham, North Carolina 27701 t 919.433.5300 f 919.433.5301 www.perkinswill.com

**CONSULTANTS** 

Lynch Mykins Structural Engineers 301 N. West Street Suite 105, Raleigh, NC 27603

> 702 Oberlin Road, Raleigh, NC 27605 License (NC): F-1434 NV5 Engineers and Consultants

Salas O'Brien

3300 Regency Parkway Suite 100, Cary, NC 27518 Holder Construction Group

6210 Ardrey Kell Road Suite 400, Charlotte, NC 28277

NV5 Engineers and Consultants 4905 Professional Court, Raleigh, NC 27609

Available Light 5700 Six Forks Road, Suite 203, Raleigh, NC 27609 SUSTAINABILITY

**Ecoimpact Consulting** 8022 Providence Road Suite 500, Charlotte, NC 28277

Mann Hall Renovation STATE ID #22-24500-02B NCSU PROJECT # 202220021



**North Carolina State** University Facilities Division Design & Construction Administrative Services Building III 2601 Wolf Village Way, Suite 331 Raleigh, NC 27695




ISSUE FOR BID - PROC 01/17/2025 ISSUE FOR BID - DEMO REV 1 10/28/2024 ISSUE FOR BID - DEMO 4/17/2024 820937.001 Approver TITLE

**EXTERIOR ENVELOPE DETAILS** 

SHEET NUMBER

A32-01

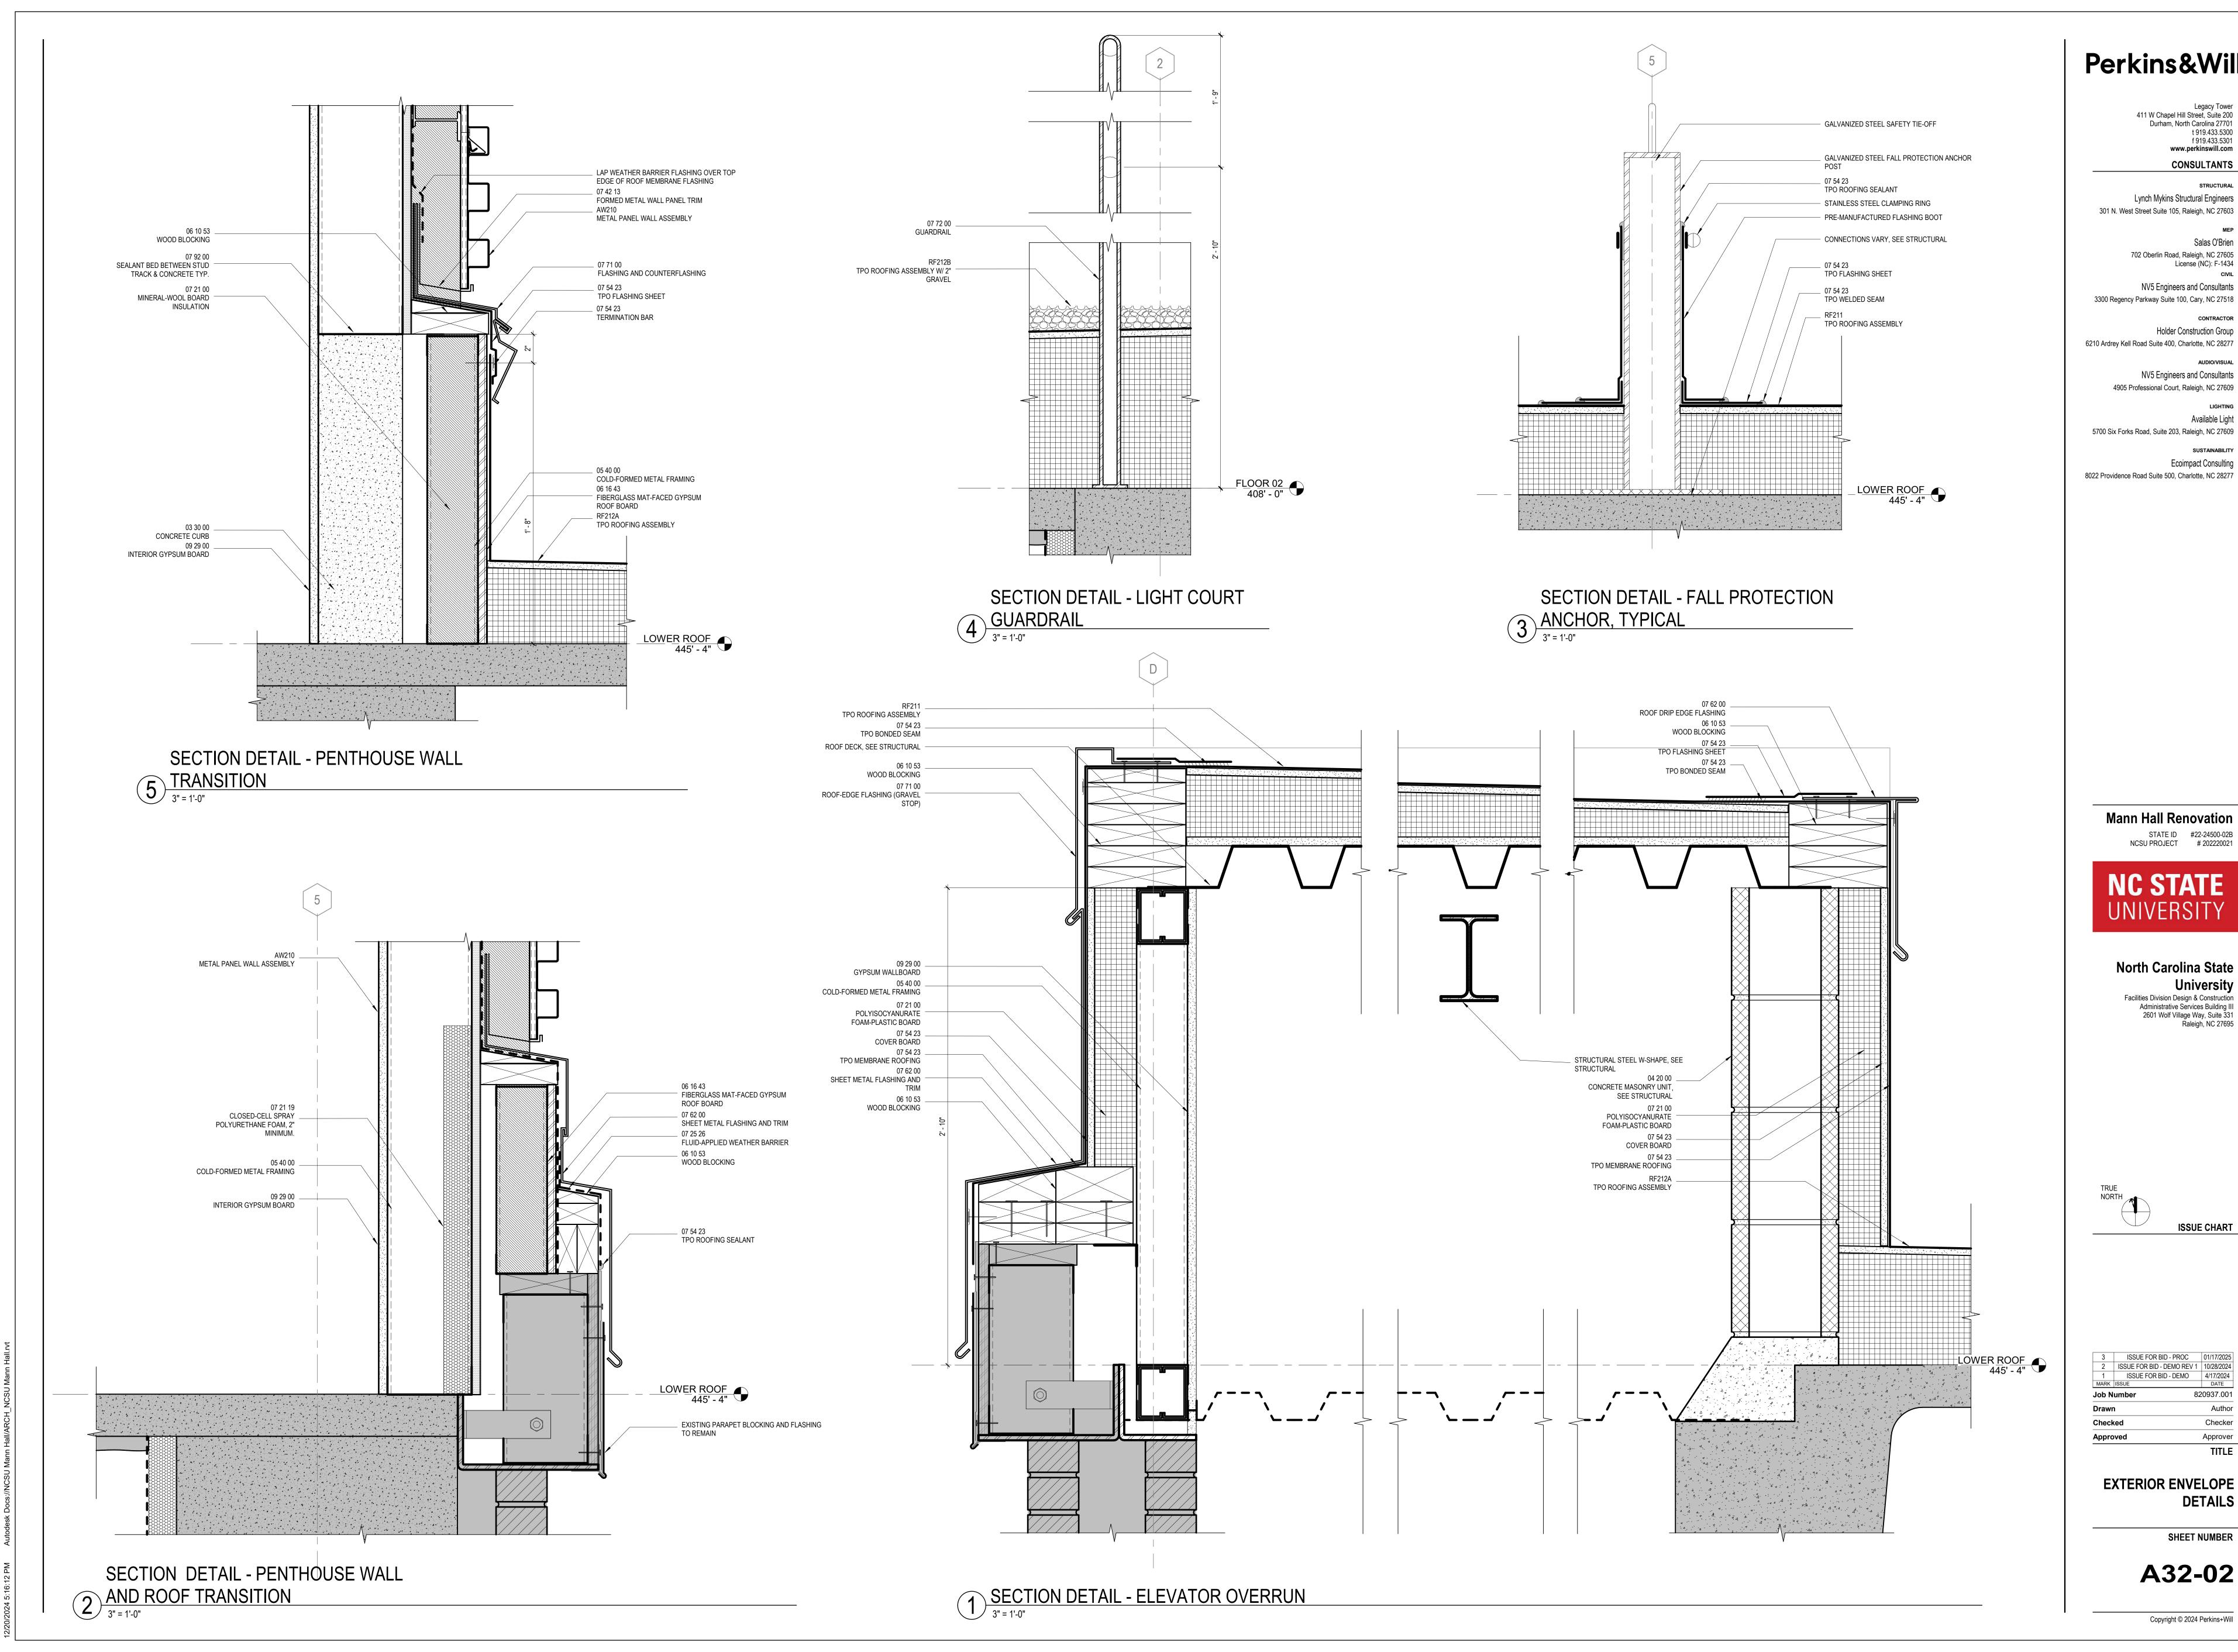

Legacy Tower 411 W Chapel Hill Street, Suite 200 Durham, North Carolina 27701 t 919.433.5300 f 919.433.5301 www.perkinswill.com

CONSULTANTS Lynch Mykins Structural Engineers

> Salas O'Brien 702 Oberlin Road, Raleigh, NC 27605 License (NC): F-1434

3300 Regency Parkway Suite 100, Cary, NC 27518 Holder Construction Group

> NV5 Engineers and Consultants 4905 Professional Court, Raleigh, NC 27609

Available Light 5700 Six Forks Road, Suite 203, Raleigh, NC 27609

SUSTAINABILITY **Ecoimpact Consulting** 

Mann Hall Renovation STATE ID #22-24500-02B

**North Carolina State** University Facilities Division Design & Construction Administrative Services Building III 2601 Wolf Village Way, Suite 331 Raleigh, NC 27695

**ISSUE CHART** 


ISSUE FOR BID - DEMO REV 1 10/28/2024 ISSUE FOR BID - DEMO 4/17/2024 Approver


**EXTERIOR ENVELOPE DETAILS** 


TITLE


SHEET NUMBER

A32-02

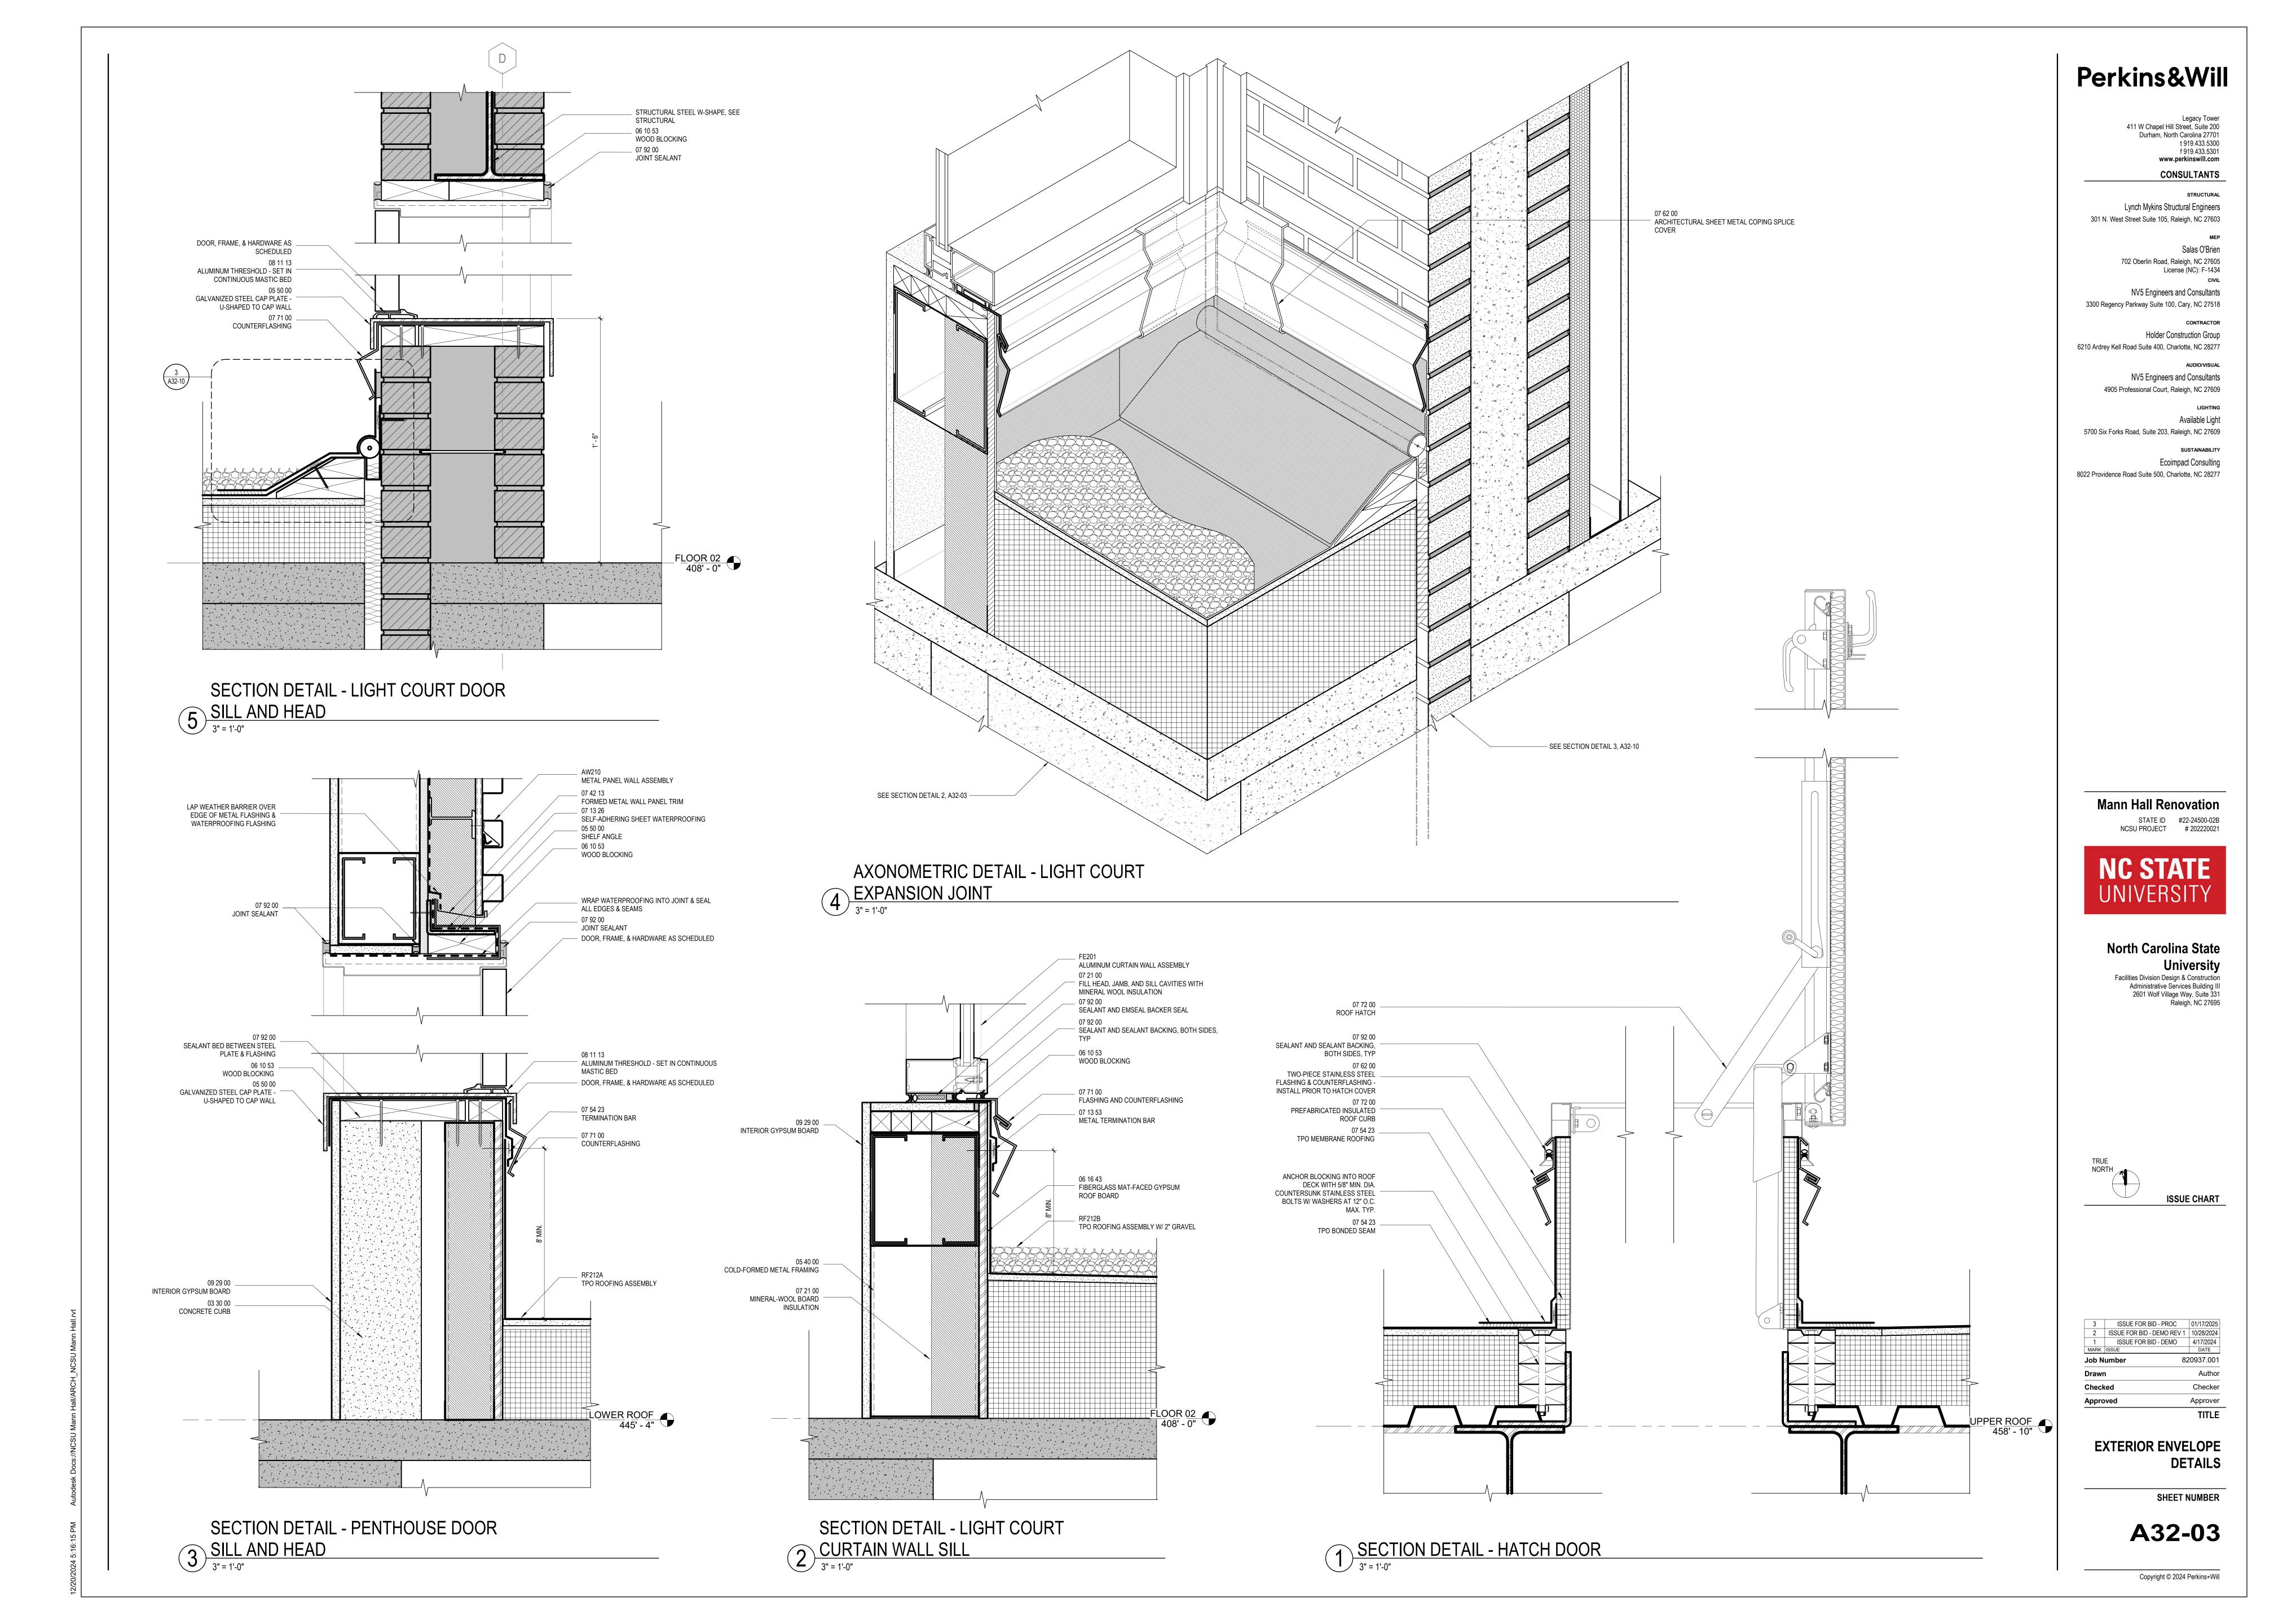

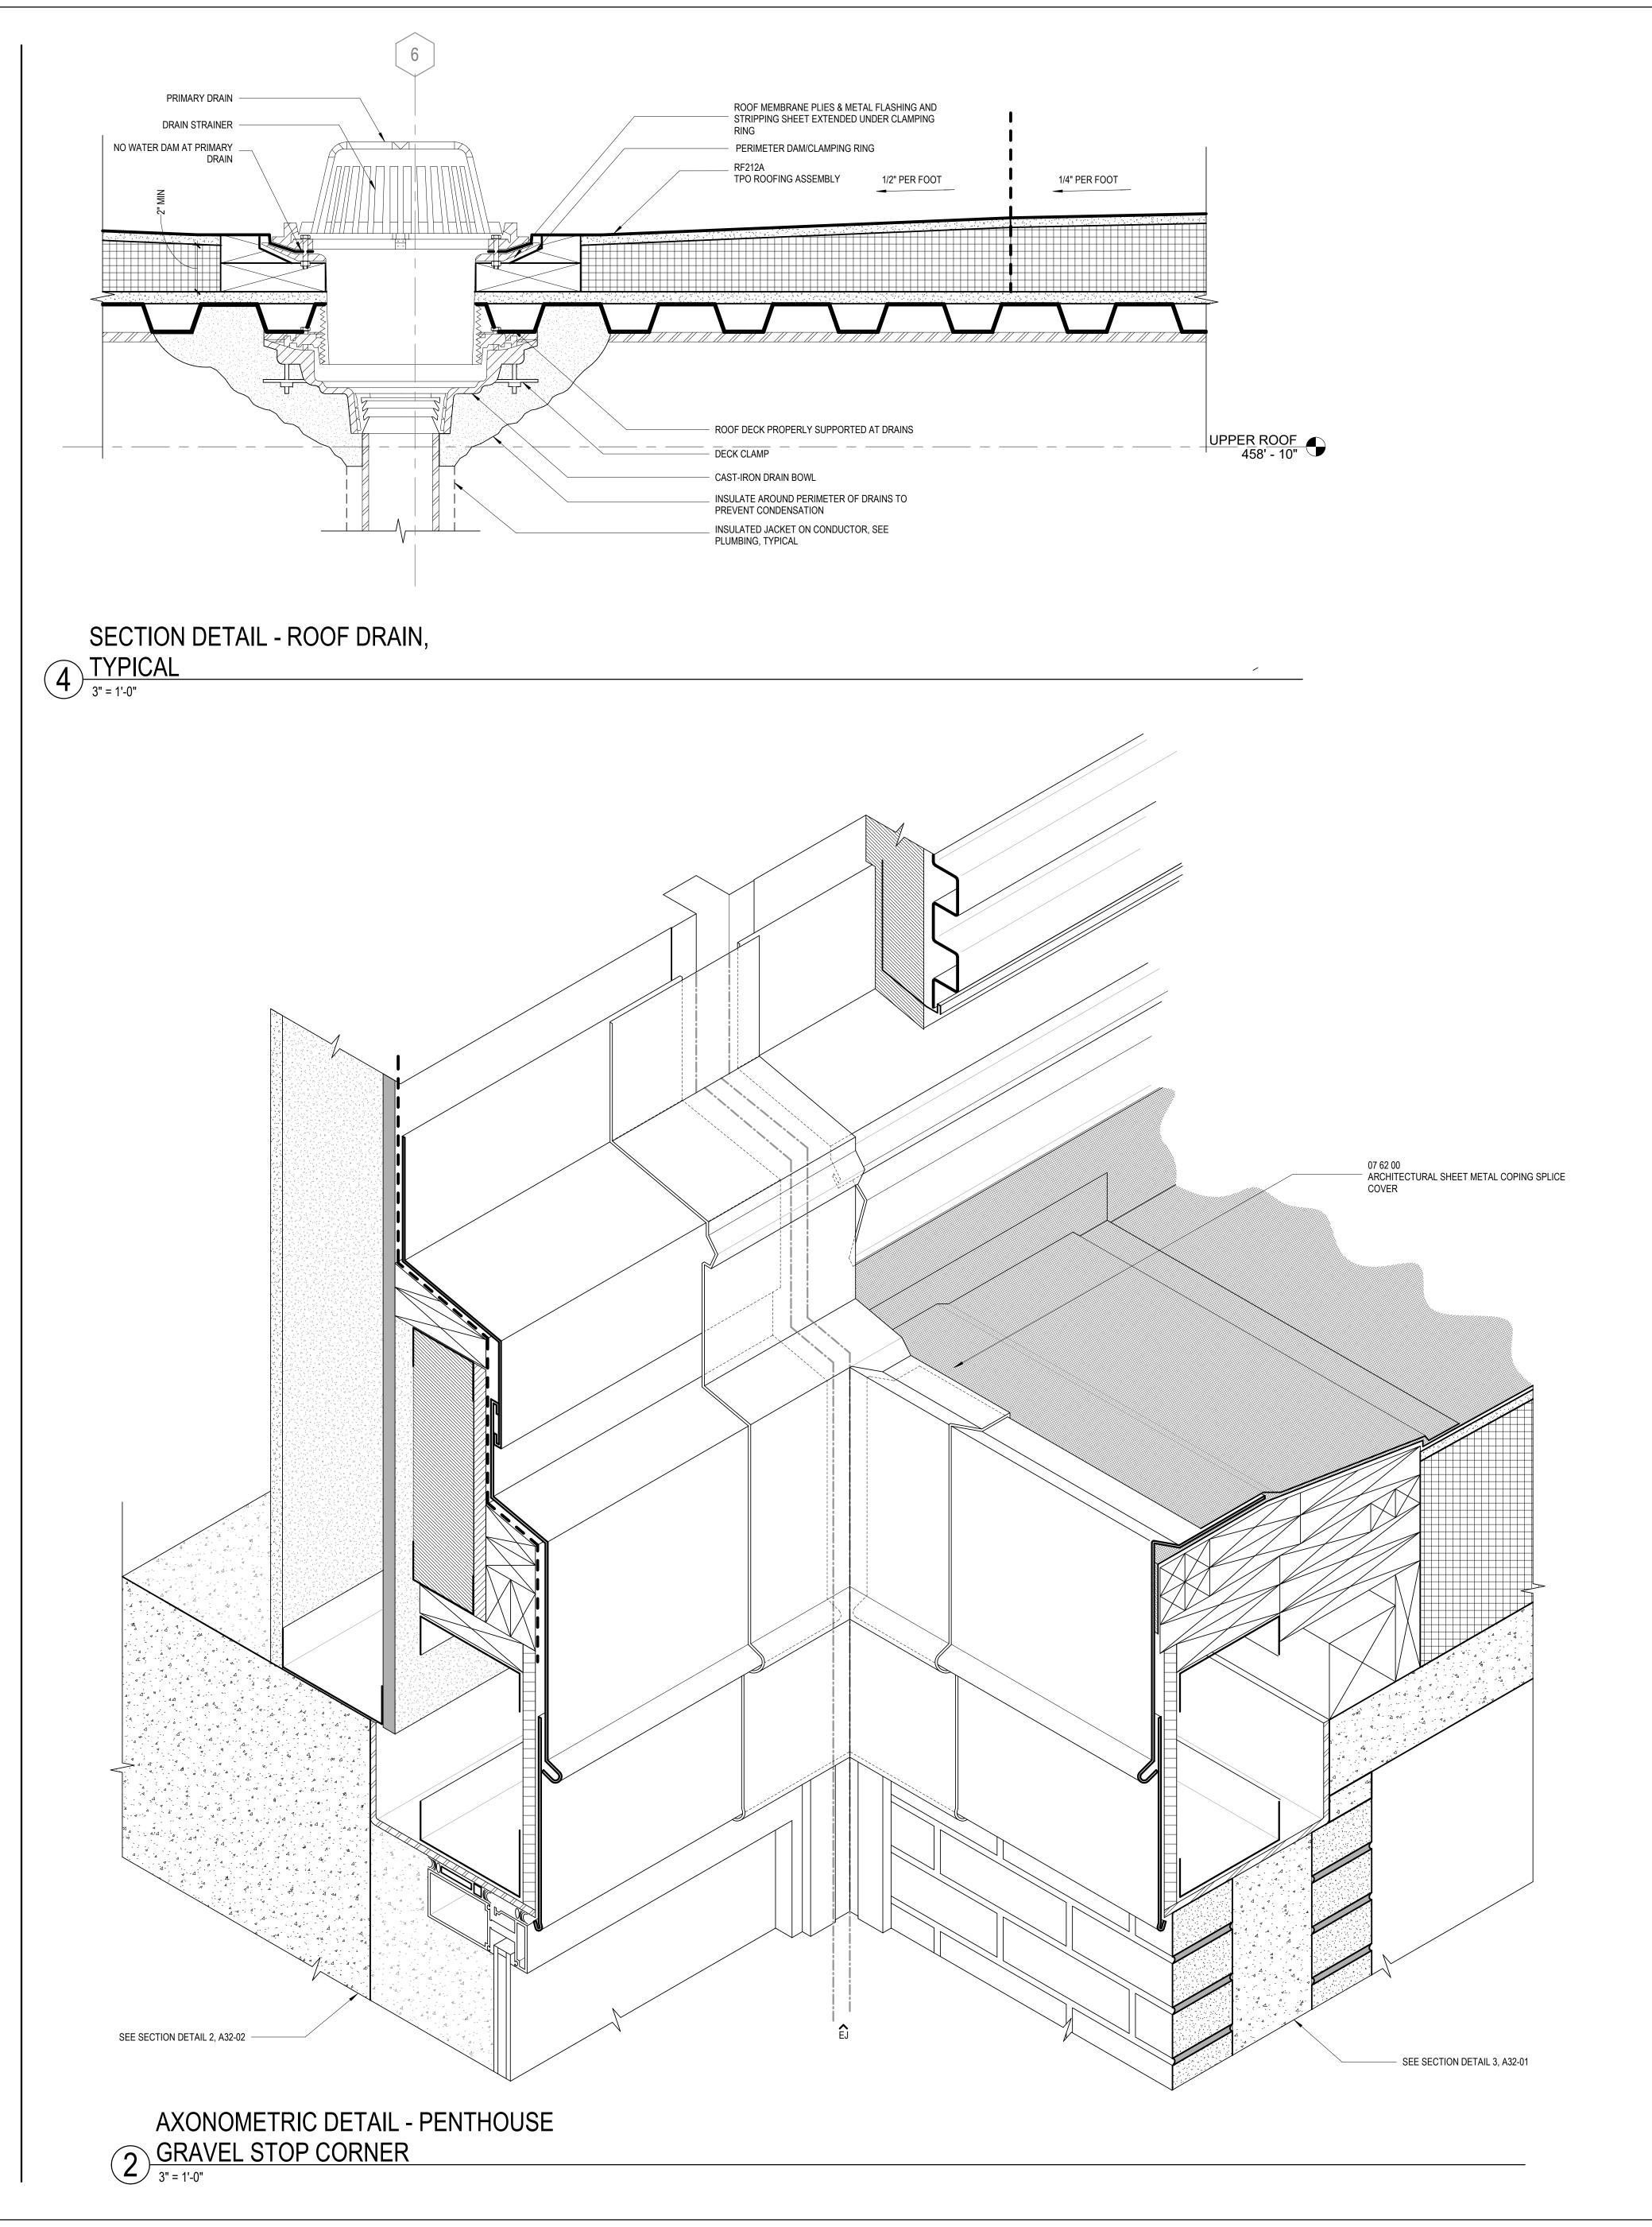

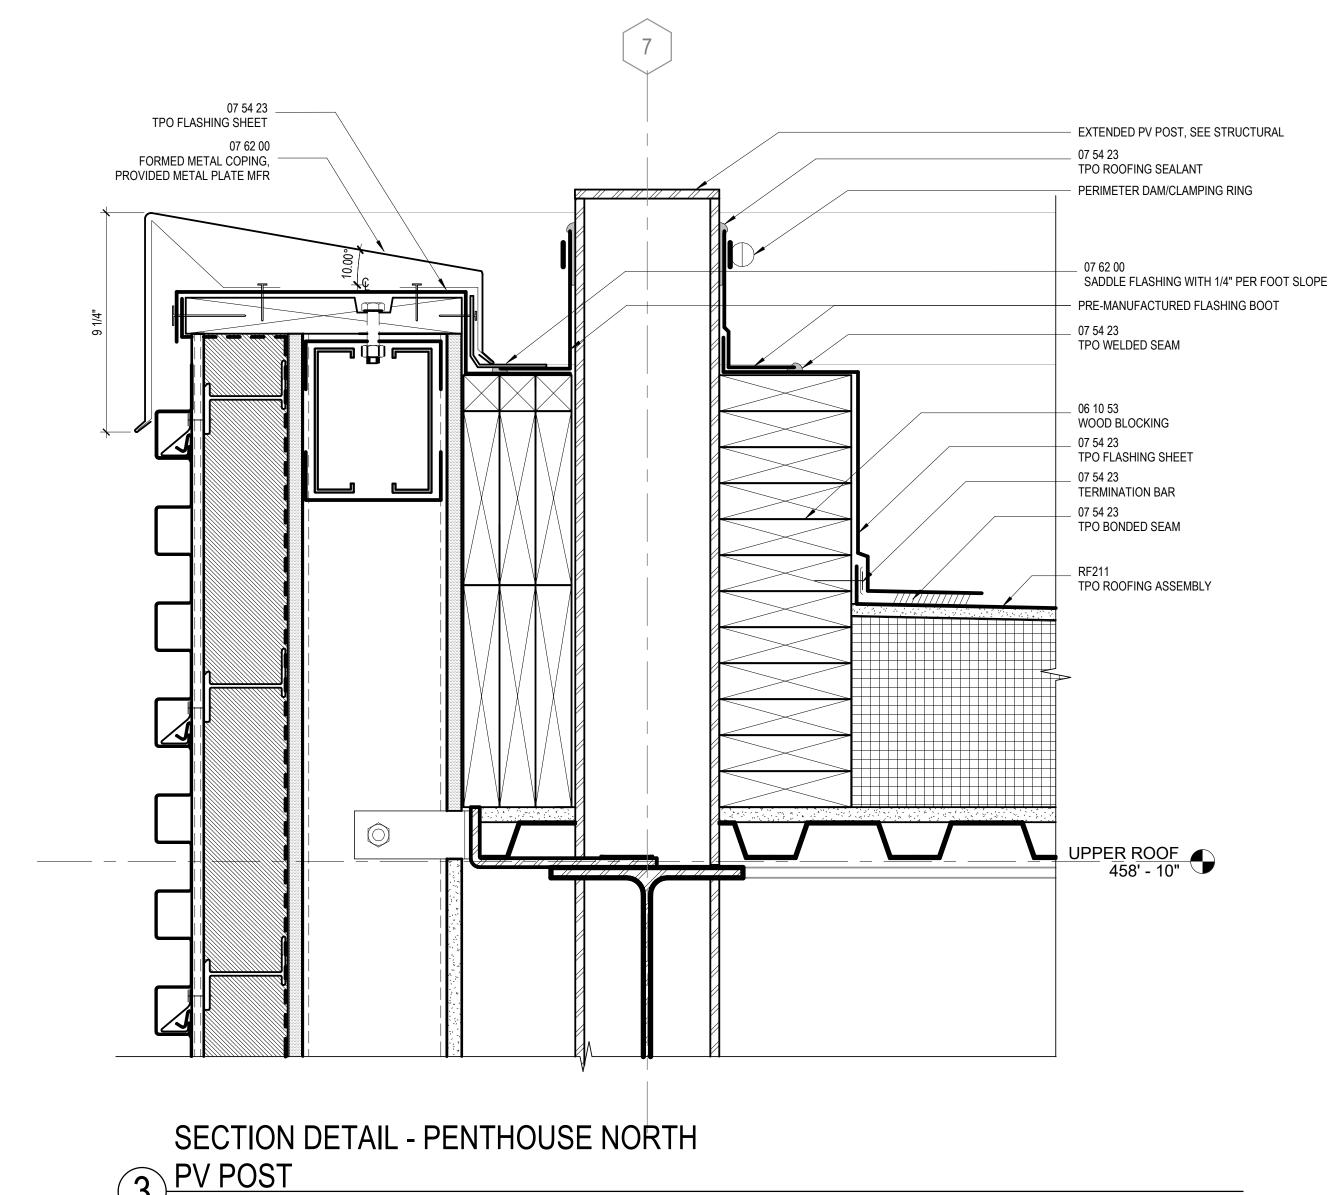

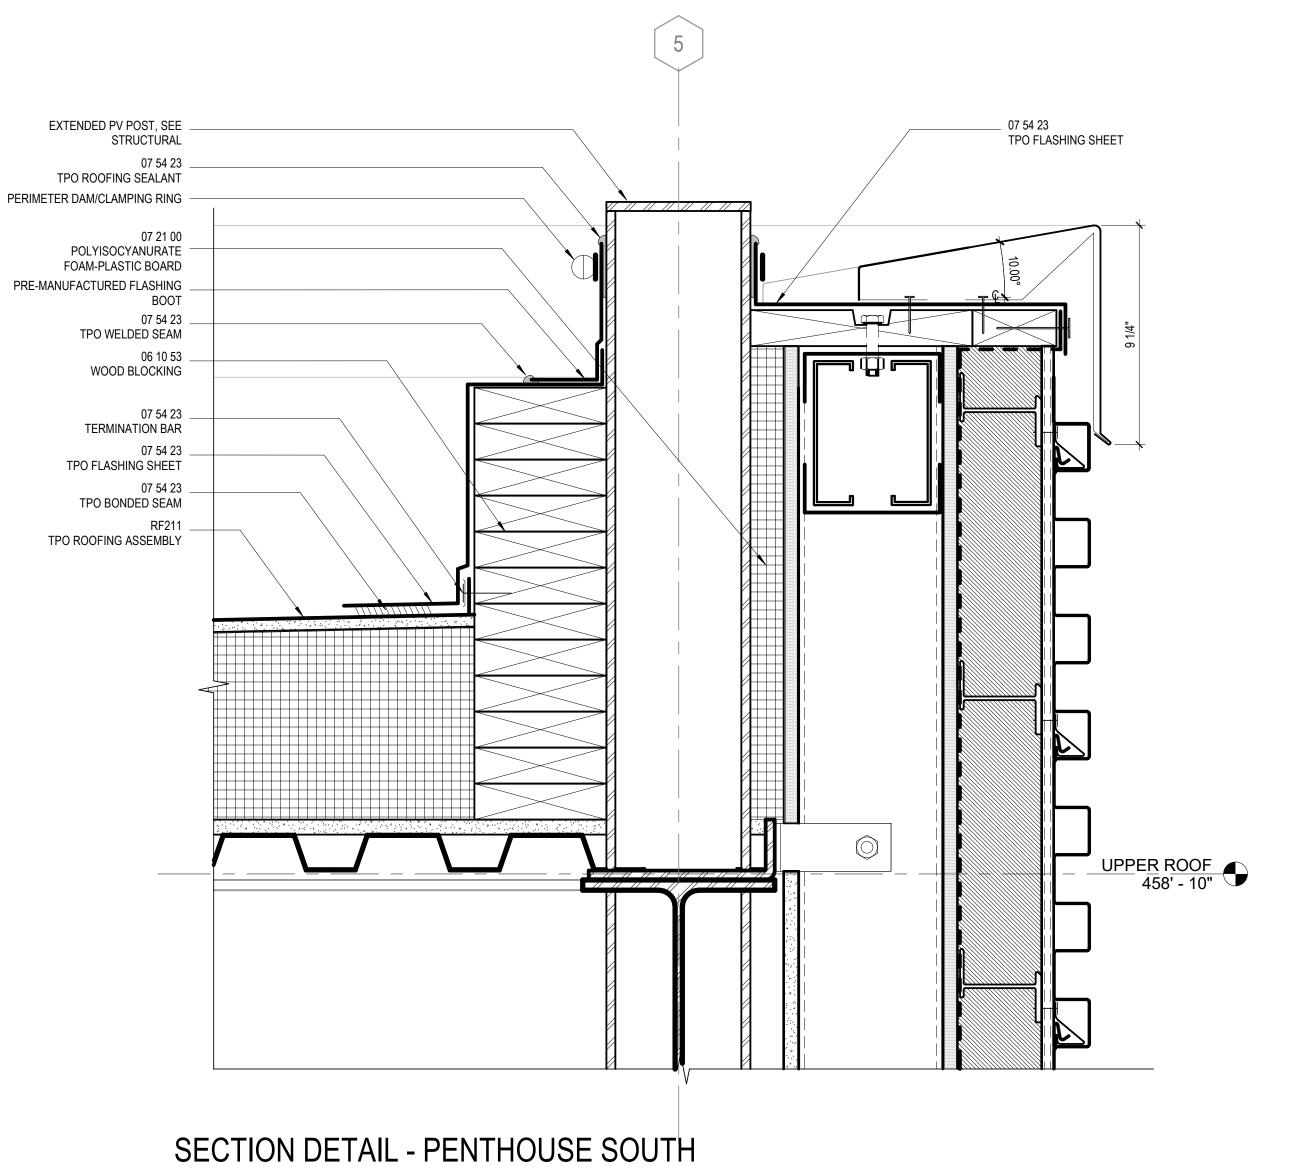

1 PV POST 3" = 1'-0"

### Perkins&Will

Legacy Tower 411 W Chapel Hill Street, Suite 200 Durham, North Carolina 27701 t 919.433.5300 f 919.433.5301 www.perkinswill.com

CONSULTANTS

Lynch Mykins Structural Engineers 301 N. West Street Suite 105, Raleigh, NC 27603

> Salas O'Brien 702 Oberlin Road, Raleigh, NC 27605 License (NC): F-1434

NV5 Engineers and Consultants 3300 Regency Parkway Suite 100, Cary, NC 27518

Holder Construction Group 6210 Ardrey Kell Road Suite 400, Charlotte, NC 28277

> NV5 Engineers and Consultants 4905 Professional Court, Raleigh, NC 27609

Available Light 5700 Six Forks Road, Suite 203, Raleigh, NC 27609

SUSTAINABILITY **Ecoimpact Consulting** 8022 Providence Road Suite 500, Charlotte, NC 28277

Mann Hall Renovation STATE ID #22-24500-02B NCSU PROJECT # 202220021



**North Carolina State** University Facilities Division Design & Construction Administrative Services Building III 2601 Wolf Village Way, Suite 331 Raleigh, NC 27695

**ISSUE CHART** 

ISSUE FOR BID - DEMO REV 1 10/28/2024 ISSUE FOR BID - DEMO 4/17/2024 TITLE


**EXTERIOR ENVELOPE DETAILS** 

SHEET NUMBER

A32-04


# RF212B TPO ROOFING ASSEMBLY W/ 2" GRAVEL TPO FLASHING SHEET 07 54 23 TPO MEMBRANE ROOFING \_ 07 54 23 TERMINATION BAR ROOF-EDGE FLASHING (GRAVEL STOP) FLOOR 02 408' - 0" FASCIA FLASHING TO COVER EXISTING STRUCTURE SECTION DETAIL - LIGHTCOURT

2 GRAVEL STOP
3" = 1'-0"

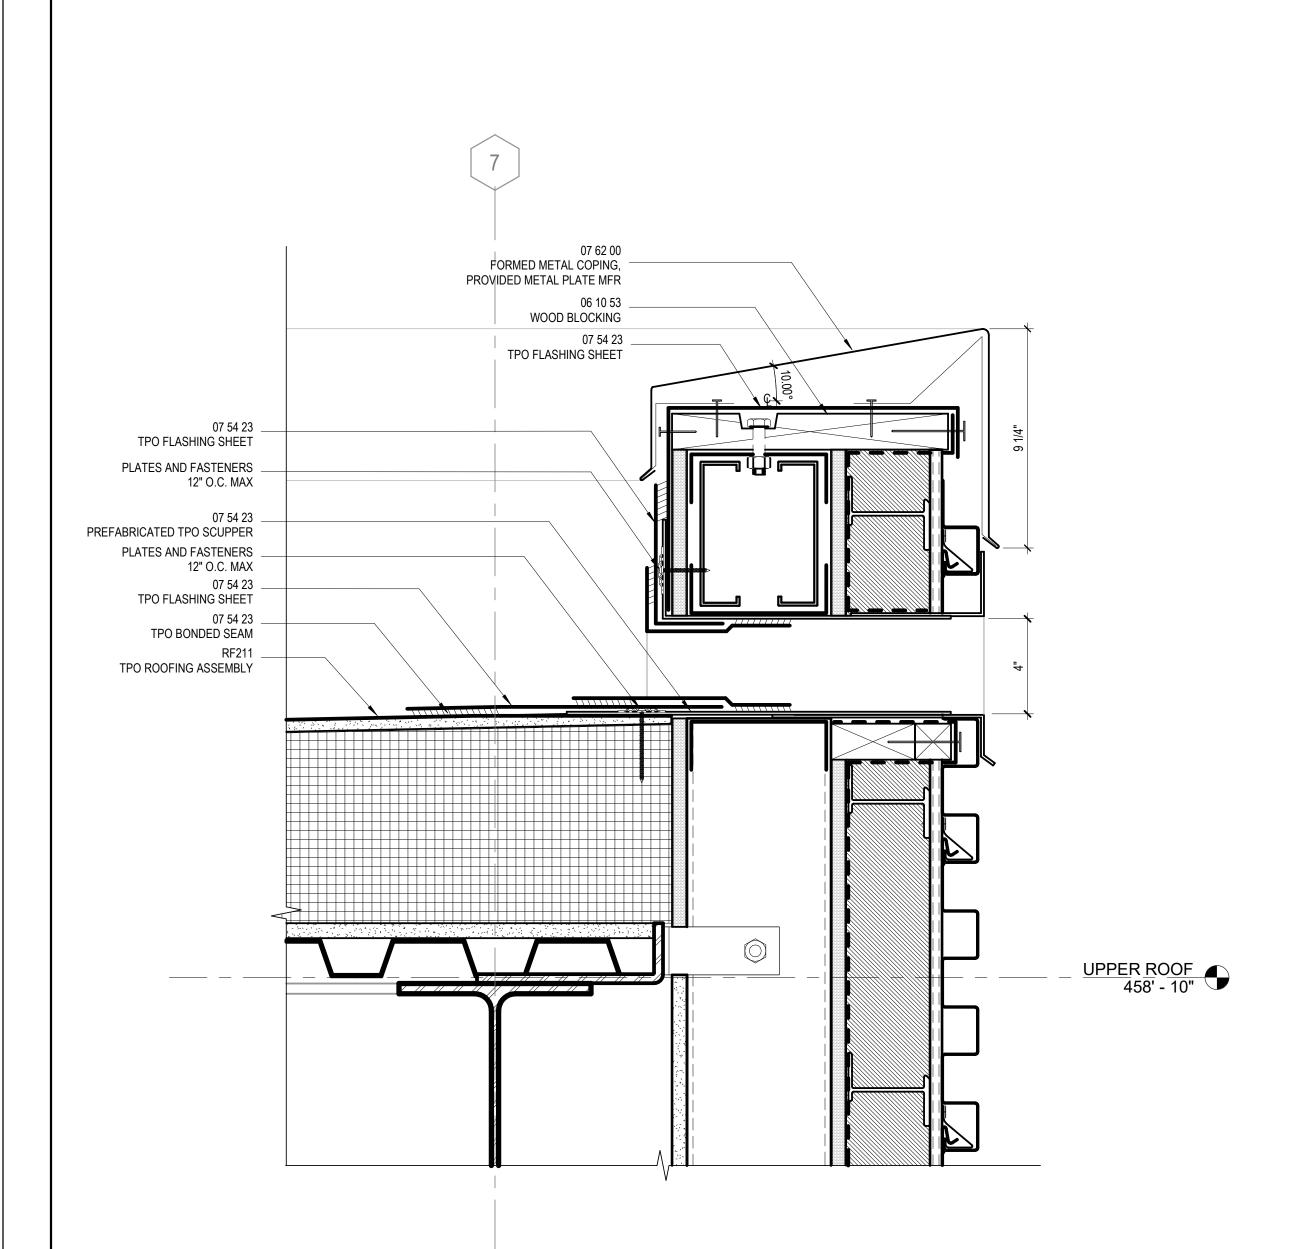

AND OPENING
3" = 1'-0"



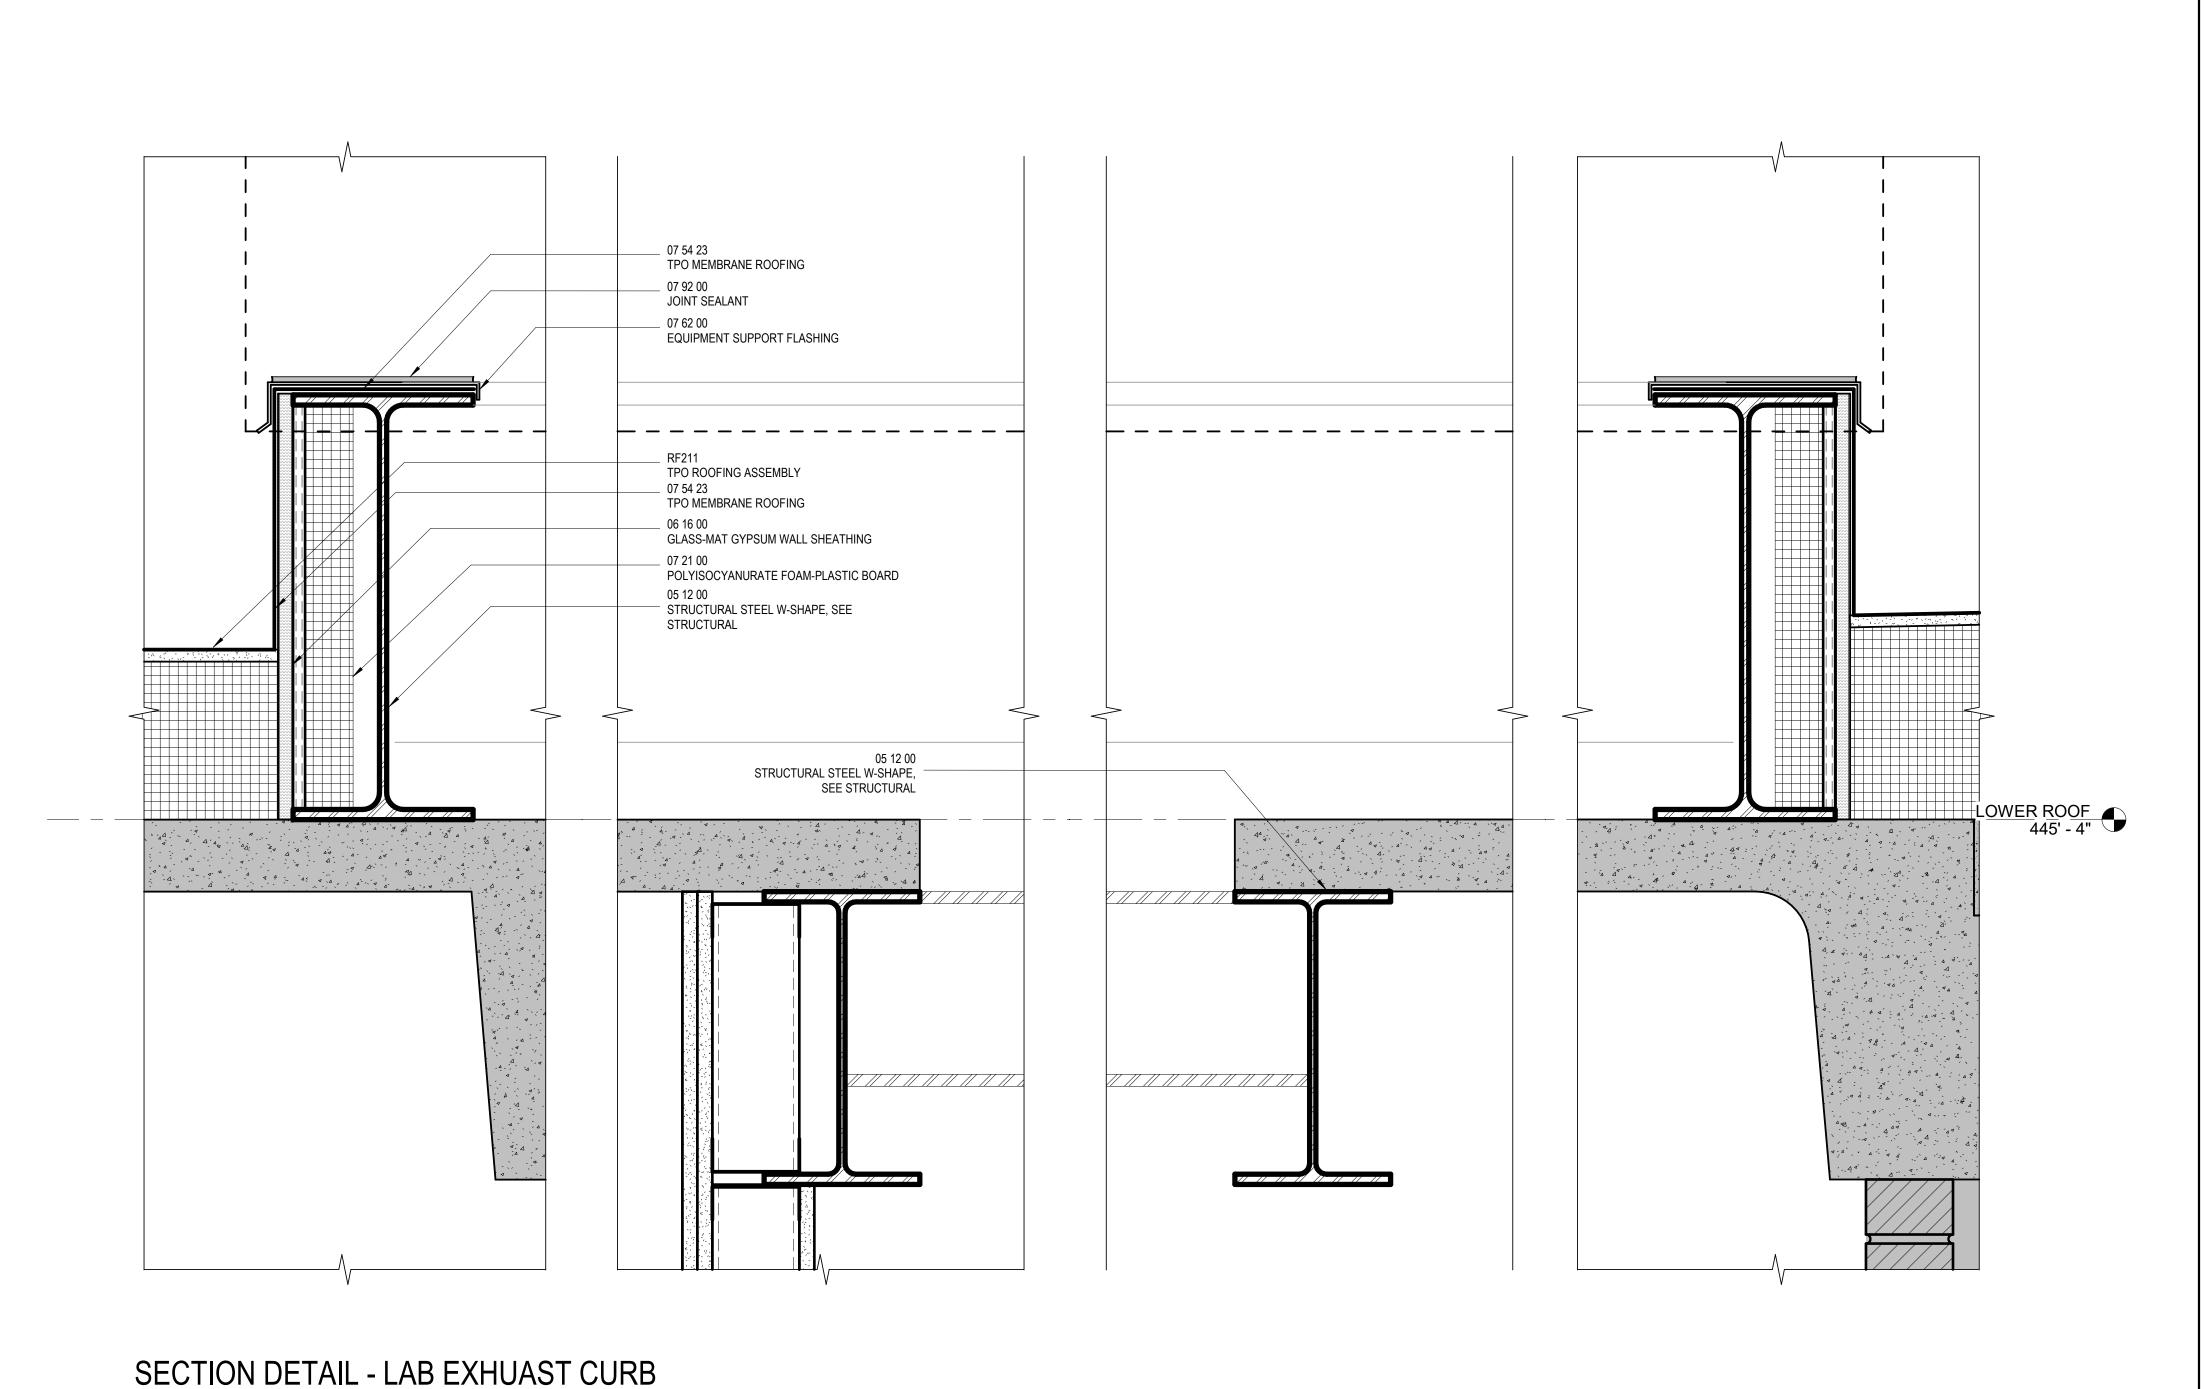

Legacy Tower 411 W Chapel Hill Street, Suite 200 Durham, North Carolina 27701 t 919.433.5300 f 919.433.5301

www.perkinswill.com CONSULTANTS

Lynch Mykins Structural Engineers 301 N. West Street Suite 105, Raleigh, NC 27603

Perkins&Will

Salas O'Brien 702 Oberlin Road, Raleigh, NC 27605 License (NC): F-1434

NV5 Engineers and Consultants 3300 Regency Parkway Suite 100, Cary, NC 27518

Holder Construction Group 6210 Ardrey Kell Road Suite 400, Charlotte, NC 28277

> NV5 Engineers and Consultants 4905 Professional Court, Raleigh, NC 27609

Available Light 5700 Six Forks Road, Suite 203, Raleigh, NC 27609

SUSTAINABILITY **Ecoimpact Consulting** 

8022 Providence Road Suite 500, Charlotte, NC 28277

Mann Hall Renovation STATE ID #22-24500-02B NCSU PROJECT # 202220021



**North Carolina State** University Facilities Division Design & Construction Administrative Services Building III 2601 Wolf Village Way, Suite 331 Raleigh, NC 27695

**ISSUE CHART** 


ISSUE FOR BID - PROC 01/17/2025 ISSUE FOR BID - DEMO REV 1 10/28/2024
ISSUE FOR BID - DEMO 4/17/2024 820937.001 Approver

**EXTERIOR ENVELOPE DETAILS** 

SHEET NUMBER

TITLE

A32-05

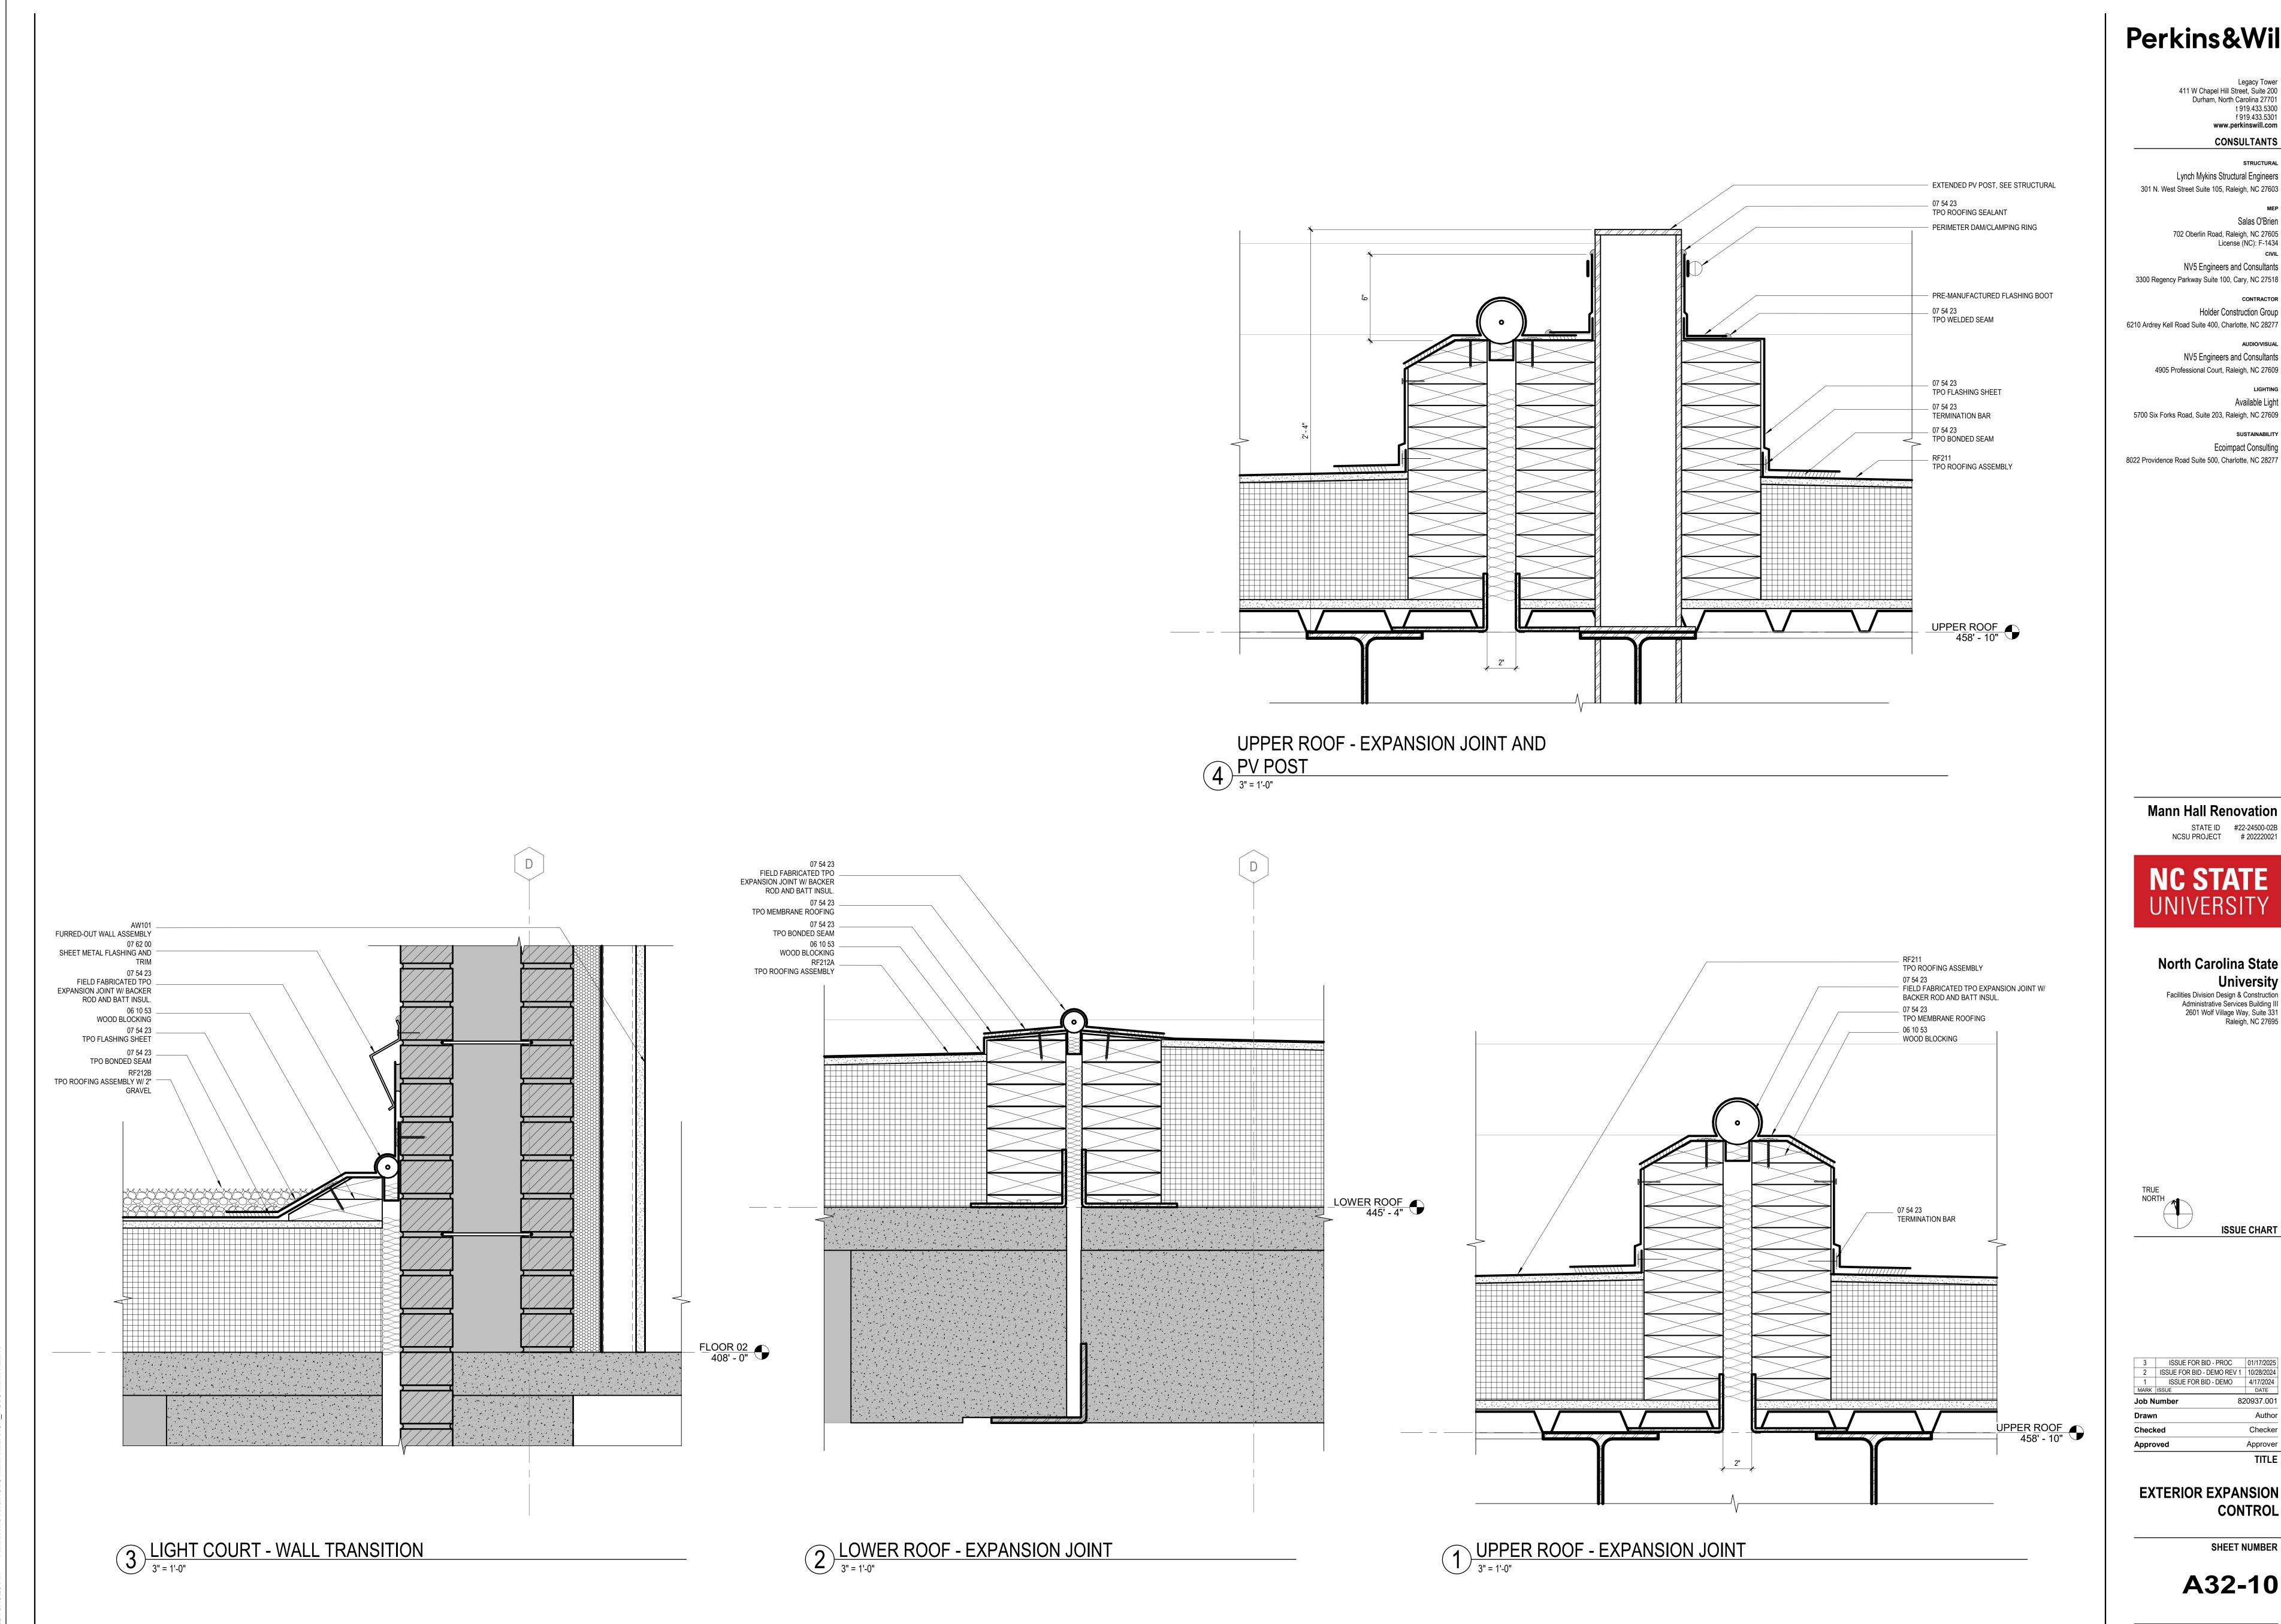

Legacy Tower 411 W Chapel Hill Street, Suite 200 Durham, North Carolina 27701 t 919.433.5300 f 919.433.5301 www.perkinswill.com

CONSULTANTS

Lynch Mykins Structural Engineers 301 N. West Street Suite 105, Raleigh, NC 27603

> Salas O'Brien 702 Oberlin Road, Raleigh, NC 27605 License (NC): F-1434

NV5 Engineers and Consultants 3300 Regency Parkway Suite 100, Cary, NC 27518

Holder Construction Group 6210 Ardrey Kell Road Suite 400, Charlotte, NC 28277

NV5 Engineers and Consultants 4905 Professional Court, Raleigh, NC 27609

Available Light

5700 Six Forks Road, Suite 203, Raleigh, NC 27609 SUSTAINABILITY **Ecoimpact Consulting** 

Mann Hall Renovation STATE ID #22-24500-02B NCSU PROJECT # 202220021



**North Carolina State** University Facilities Division Design & Construction Administrative Services Building III 2601 Wolf Village Way, Suite 331 Raleigh, NC 27695




ISSUE FOR BID - PROC 01/17/2025 ISSUE FOR BID - DEMO REV 1 10/28/2024 ISSUE FOR BID - DEMO 4/17/2024 Approver TITLE

**EXTERIOR EXPANSION** CONTROL

SHEET NUMBER

A32-10

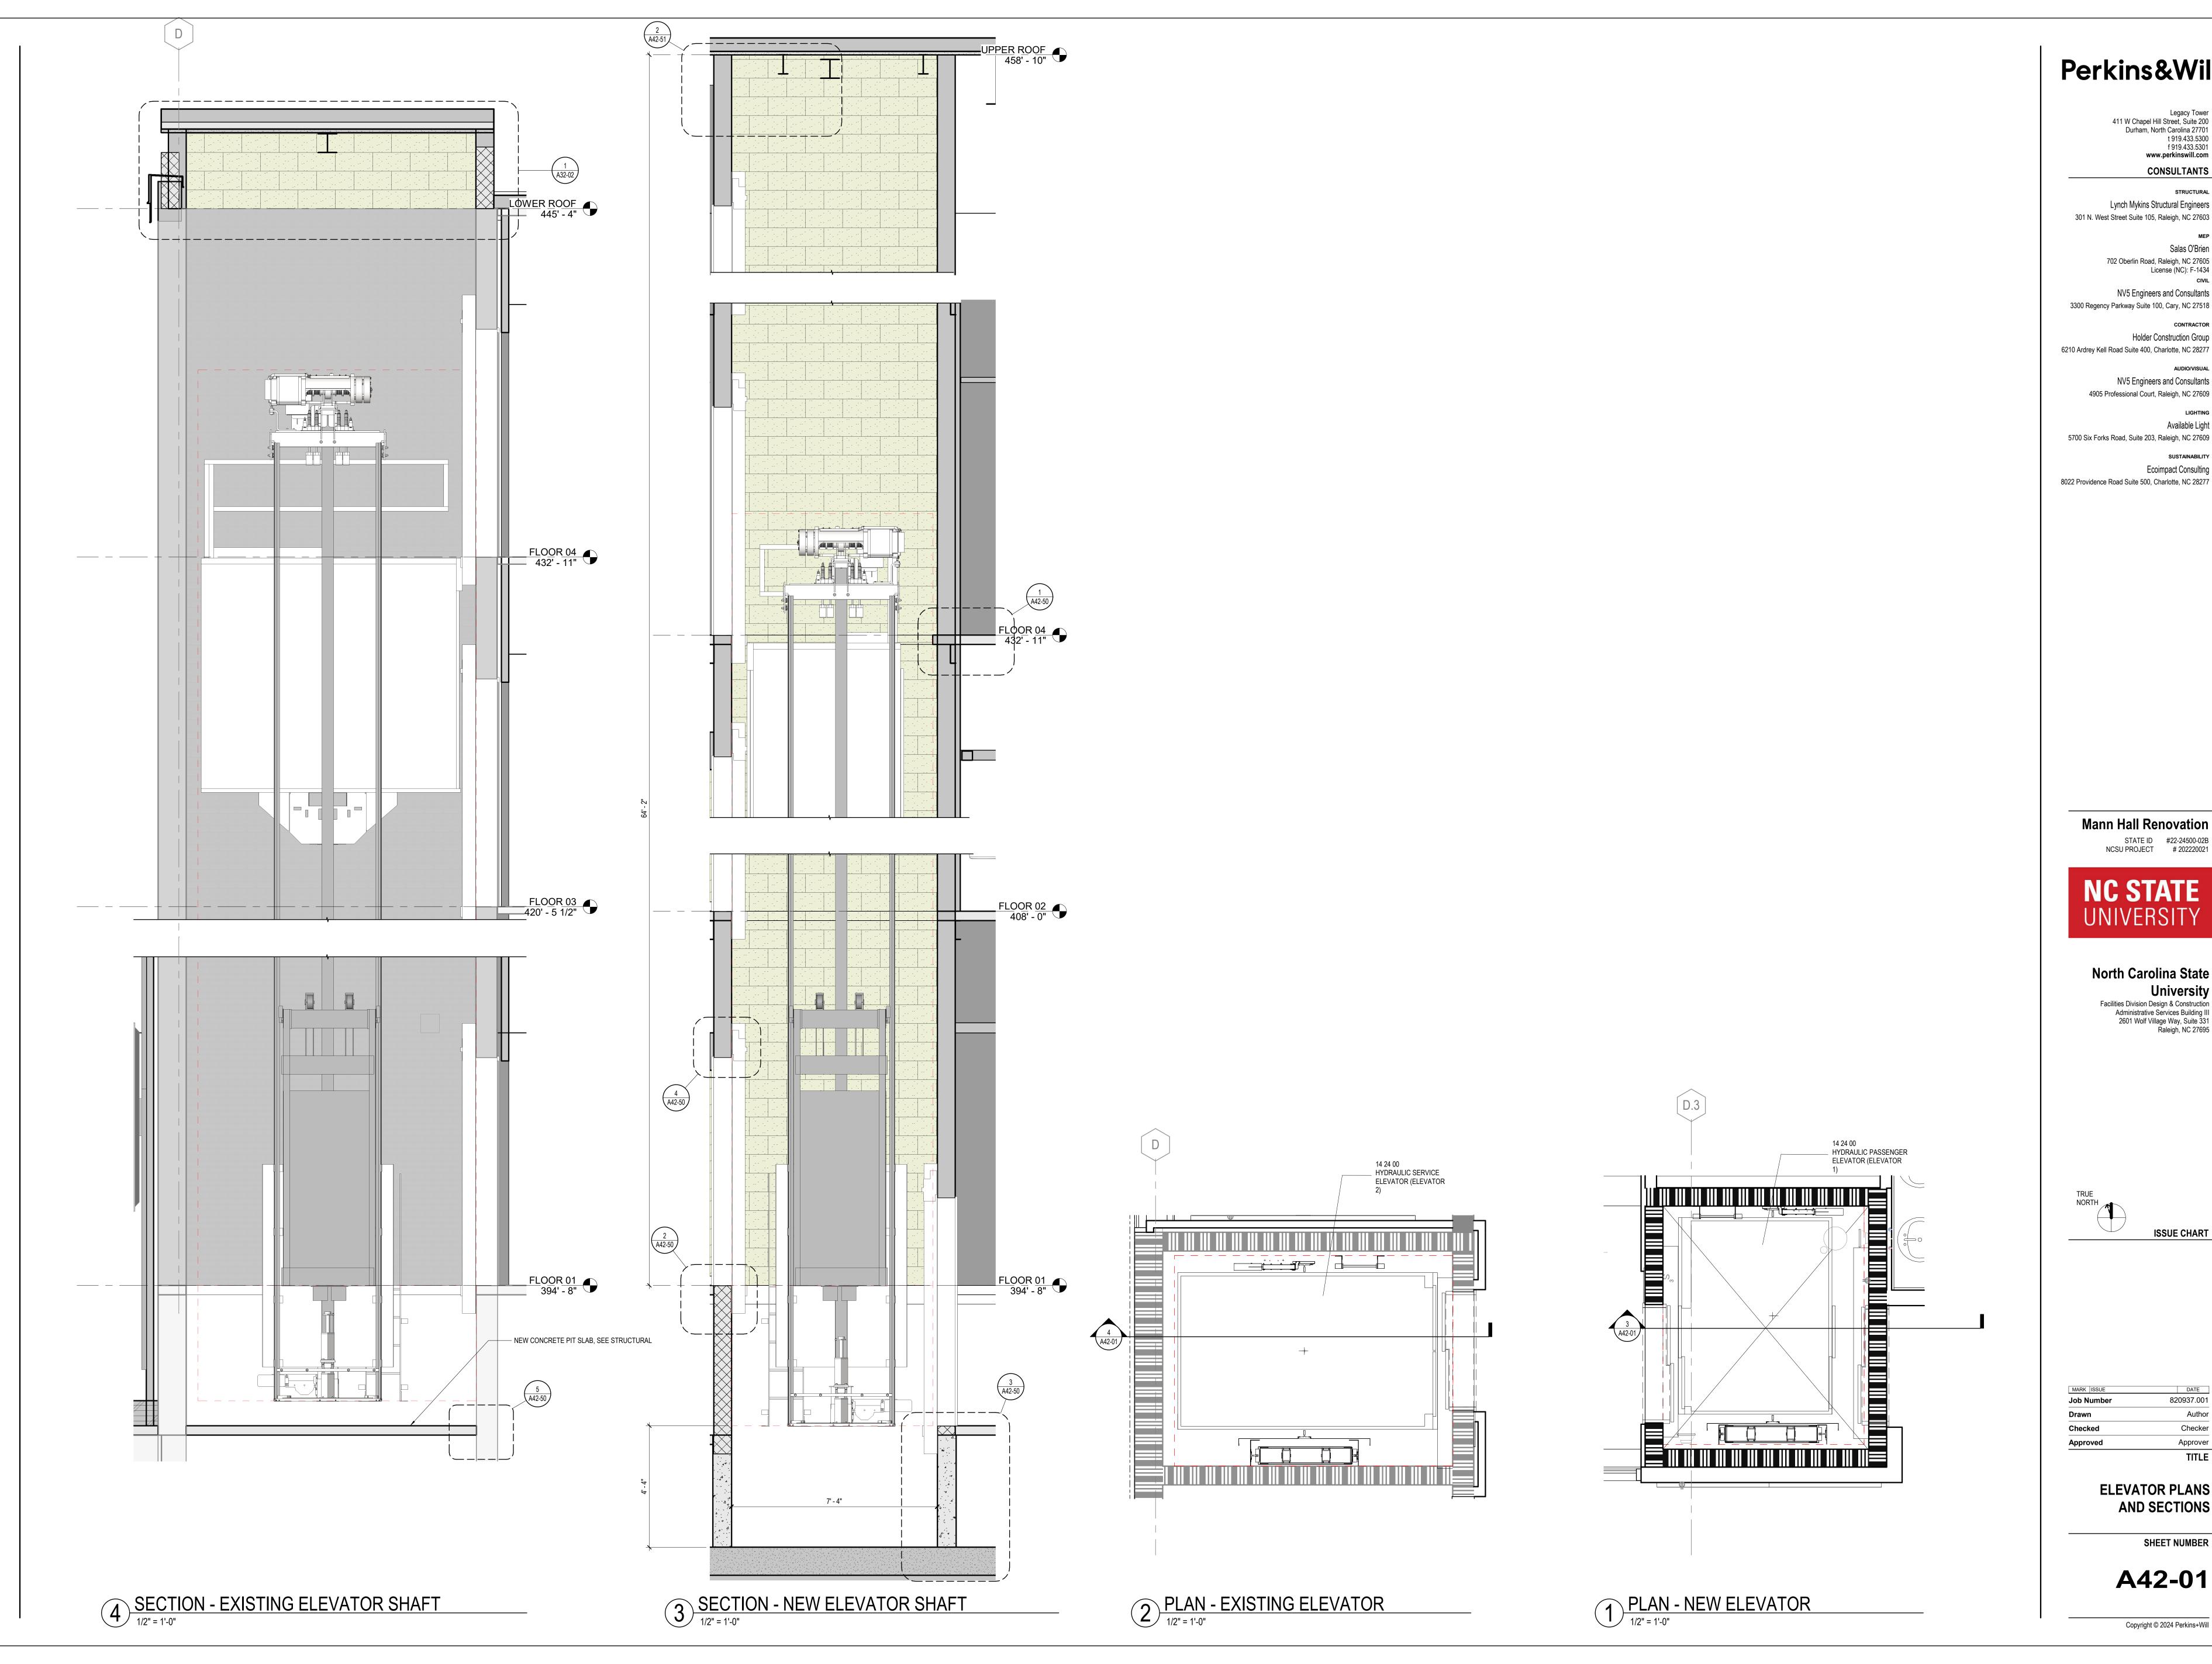

Legacy Tower 411 W Chapel Hill Street, Suite 200 Durham, North Carolina 27701 t 919.433.5300 f 919.433.5301 www.perkinswill.com

CONSULTANTS

Lynch Mykins Structural Engineers 301 N. West Street Suite 105, Raleigh, NC 27603

> Salas O'Brien 702 Oberlin Road, Raleigh, NC 27605 License (NC): F-1434

NV5 Engineers and Consultants 3300 Regency Parkway Suite 100, Cary, NC 27518

Holder Construction Group 6210 Ardrey Kell Road Suite 400, Charlotte, NC 28277

NV5 Engineers and Consultants 4905 Professional Court, Raleigh, NC 27609

Available Light 5700 Six Forks Road, Suite 203, Raleigh, NC 27609

SUSTAINABILITY **Ecoimpact Consulting** 

Mann Hall Renovation STATE ID #22-24500-02B NCSU PROJECT # 202220021



**North Carolina State** University Facilities Division Design & Construction Administrative Services Building III 2601 Wolf Village Way, Suite 331 Raleigh, NC 27695



|            | TITLE      |  |
|------------|------------|--|
| Approved   | Approver   |  |
| Checked    | Checker    |  |
| Drawn      | Author     |  |
| Job Number | 820937.001 |  |
| MARK ISSUE | DATE       |  |


**ELEVATOR PLANS AND SECTIONS** 

SHEET NUMBER

A42-01

# - REF. A11-00S FOR SCHEUDLED DOOR OR PARTITION 03 15 26 UNDERSLAB SHEET VAPOR BARRIER - STRUCTURAL SLAB. 4. 4. 4. 4. 4. 4. 4. 4. 4. 4. REF. TO STRUCTURAL - WATERPROOFING TO VAPOR BARRIER TRANSITION TAPE NEGATIVE-SIDE SHEET WATERPROOFING MEMBRANE 03 30 00 CONCRETE PIT WALL. REFER TO STRUCTURAL CONTINUOUS WATERSTOP - WATERPROOFING TRANSITION TAPE CONTINUOUS WATERSTOP ELEVATOR PIT


3 SECTION - NEW ELEVATOR SHAFT PIT

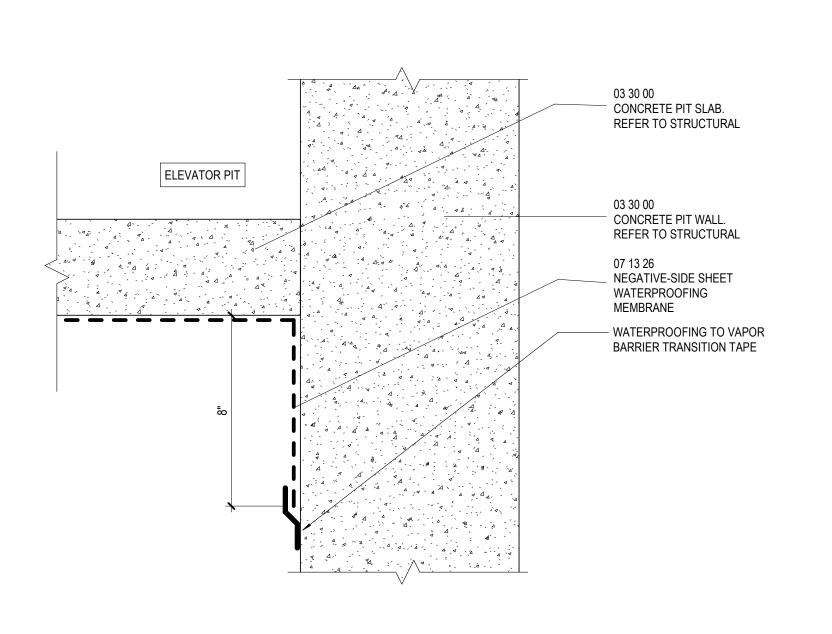

SECTION - EXISTING ELEVATOR SHAFT

WATERPROOFING


3" = 1'-0"

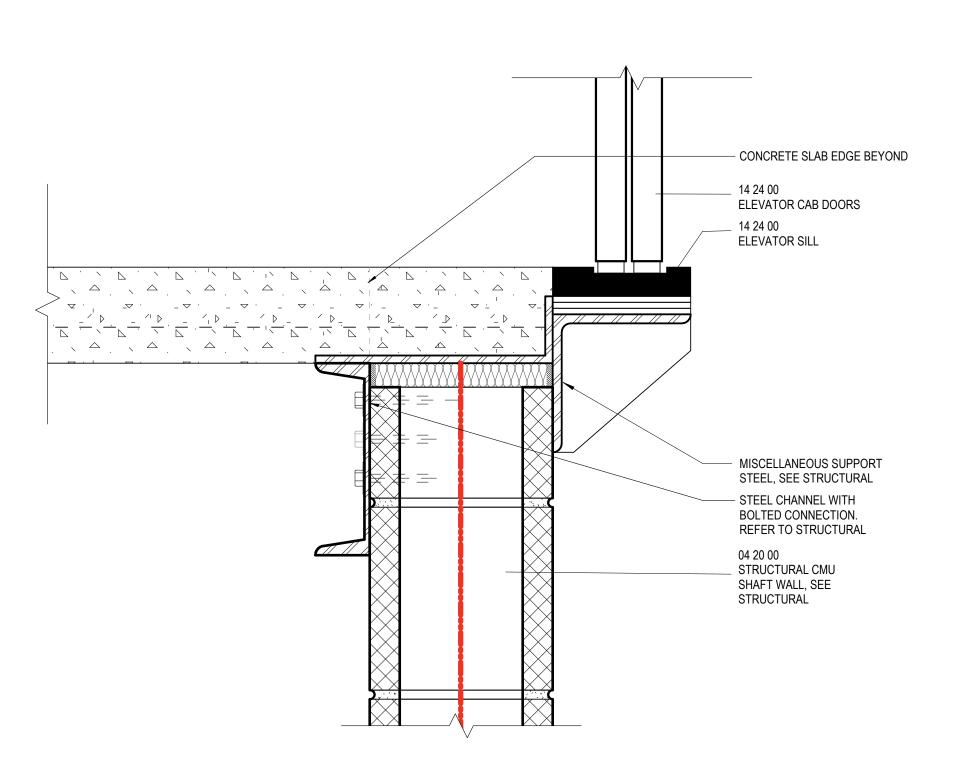

SECTION - TYP THRESHOLD @ NEW

ELEVATOR SHAFT


3" = 1'-0"

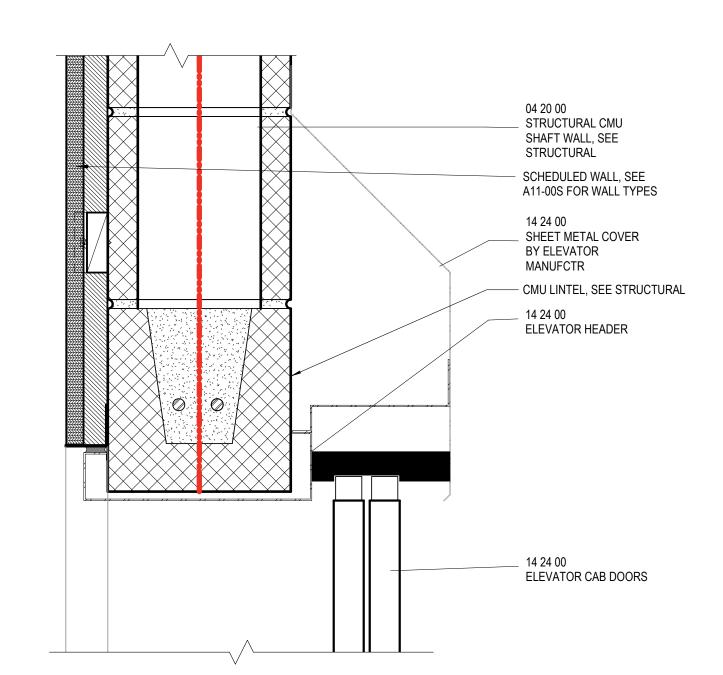

SECTION - TYP DOOR HEAD @ NEW

ELEVATOR

3" = 1'-0"

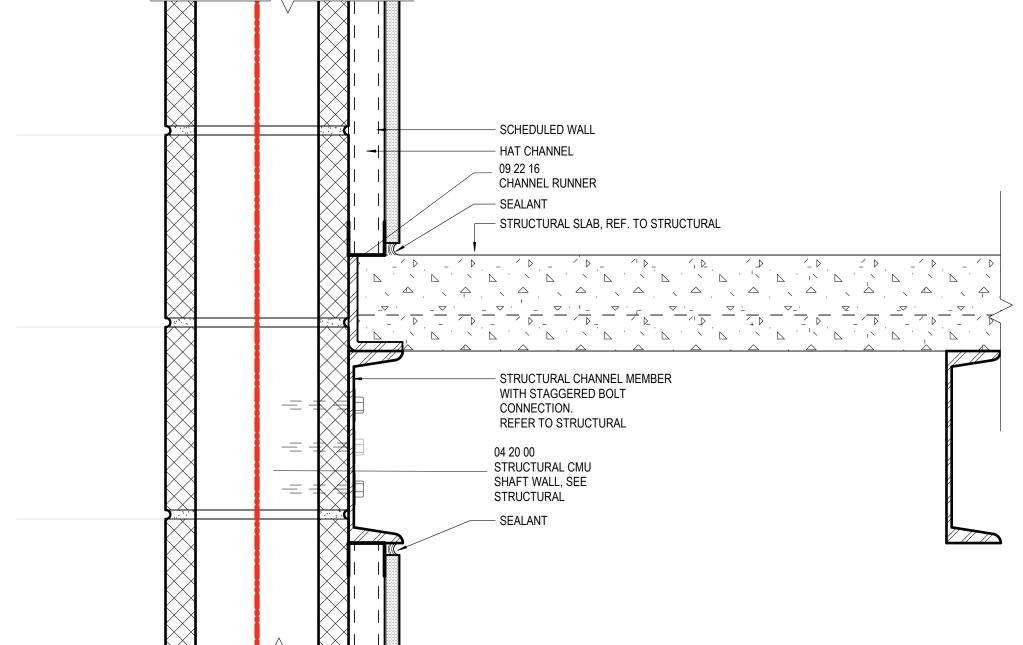

SECTION - TYP EDGE OF SLAB @ NEW

1 ELEVATOR
3" = 1'-0"

Perkins&Will

Legacy Tower
411 W Chapel Hill Street, Suite 200
Durham, North Carolina 27701
t 919.433.5300
f 919.433.5301
www.perkinswill.com

CONSULTANTS

STRUCTURAL

Lynch Mykins Structural Engineers

301 N. West Street Suite 105, Raleigh, NC 27603

Salas O'Brien 702 Oberlin Road, Raleigh, NC 27605 License (NC): F-1434

NV5 Engineers and Consultants
3300 Regency Parkway Suite 100, Cary, NC 27518

CONTRACTOR
Holder Construction Group
6210 Ardrey Kell Road Suite 400, Charlotte, NC 28277

O Ardrey Kell Road Suite 400, Charlotte, NC 28277

AUDIO/VISUAL

NV5 Engineers and Consultants

4905 Professional Court, Raleigh, NC 27609

Available Light 5700 Six Forks Road, Suite 203, Raleigh, NC 27609

SUSTAINABILITY

Ecoimpact Consulting
8022 Providence Road Suite 500, Charlotte, NC 28277

Mann Hall Renovation

STATE ID #22-24500-02B

NCSU PROJECT # 202220021



North Carolina State
University
Facilities Division Design & Construction
Administrative Services Building III
2601 Wolf Village Way, Suite 331
Raleigh, NC 27695



 3
 ISSUE FOR BID - PROC
 01/17/2025

 MARK
 ISSUE
 DATE

 Job Number
 820937.001

 Drawn
 Author

 Checked
 Checker

 Approved
 Approver

EDGE OF SLAB AND SHAFT DETAILS

SHEET NUMBER

TITLE

A42-50